



UTILITIES, INC. OF FLORIDA SHADOW HILLS SPRINGS BLVD FORCE MAIN SEMINOLE COUNTY, FLORIDA


SHEET INDEX

- 1 - COVER SHEET
- 2 - GENERAL NOTES
- 3 - KEY SHEET
- 4 - STA 00+00 TO STA 14+25
- 5 - STA 14+25 TO STA 30+30
- 6 - STA 30+30 TO STA 40+80
- 7 - STA 40+80 TO STA 54+75
- 8 - STA 54+75 TO STA 69+60
- 9 - LIFT STATION F3/SPRINGS BLVD CONNECTION DETAILS
- 10 - STANDARD DETAILS
- 11 - STANDARD DETAILS

NOVEMBER 2016

OWNER:
UTILITIES, INC. OF FLORIDA
200 WEATHERSFIELD AVE.
ALTAMONTE SPRINGS, FL 32714
CONTACT: MR. BRYAN GONGRE
866-842-8432 EXT. 1360

ENGINEER:
KIMLEY-HORN AND ASSOCIATES, INC.
3660 MAGUIRE BLVD, SUITE 200
ORLANDO, FLORIDA 32803
CONTACT: STEPHEN N. ROMANO, P.E.
407-427-1637

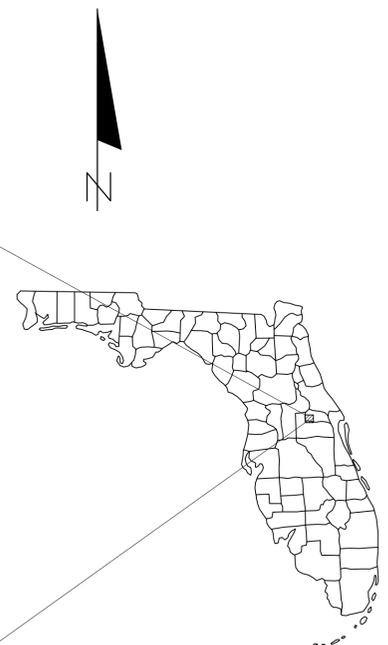

PROJECT VICINITY MAP
N.T.S.

THE SITE CONSTRUCTION STAKEOUT SHALL BE PERFORMED UNDER THE DIRECTION OF A FLORIDA REGISTERED SURVEYOR. AUTOCAD FILES WILL BE FURNISHED TO AID IN THE SITE CONSTRUCTION STAKEOUT. ANY DISCREPANCIES FOUND BETWEEN AUTOCAD FILES AND SITE CONSTRUCTION PLANS SHALL BE BROUGHT TO THE ENGINEER'S ATTENTION FOR CLARIFICATION PRIOR TO THAT STAKEOUT.

PREPARED BY
Kimley»Horn

© 2016 KIMLEY-HORN AND ASSOCIATES, INC.
3660 MAGUIRE BOULEVARD, SUITE 200,
ORLANDO, FL 32803
PHONE (813) 620-1460
WWW.KIMLEY-HORN.COM CA 0000696

No.	REVISIONS	DATE	BY

THIS DOCUMENT IS PROTECTED BY SECTION 106 OF THE "UNITED STATES COPYRIGHT ACT". REPRODUCTION OR ALTERATION OF THIS DOCUMENT OR THE INFORMATION CONTAINED HEREON BY ANY MEANS WHATSOEVER IS STRICTLY PROHIBITED WITHOUT THE PRIOR WRITTEN CONSENT OF KIMLEY-HORN AND ASSOCIATES, INC. CONSENT IS HEREBY GRANTED SPECIFICALLY TO GOVERNMENTAL AGENCIES TO REPRODUCE THIS DOCUMENT IN COMPLIANCE WITH F.S. CHAPTER 119.

STEPHEN N. ROMANO, P.E.
FLORIDA LICENSE NUMBER:
57579
DATE: 11/7/16

DATE NOV, 2016
PROJECT NO. 149685007
SHEET NUMBER 1

This document, together with the concepts and designs presented herein, is an instrument of service, is intended only for the specific purpose and client for which it was prepared. Reuse of any information or adaptation by Kimley-Horn and Associates, Inc. will be without liability to Kimley-Horn and Associates, Inc.

GENERAL PROJECT DATA

FOR IDENTIFICATION OF CONTRACTUAL AGREEMENTS, THIS SET OF DRAWINGS IS DATED NOV 2016. ANY REVISIONS THEREAFTER WILL BE NOTED AND DATED ON THE AFFECTED DRAWING(S).

EXISTING UTILITY LOCATION

THE LOCATIONS OF ALL EXISTING UTILITIES SHOWN ON THE PLANS HAVE BEEN DETERMINED FROM THE BEST INFORMATION AVAILABLE AND ARE GIVEN FOR THE CONVENIENCE OF THE CONTRACTOR. THE ENGINEER ASSUMES NO RESPONSIBILITY FOR THEIR ACCURACY. PRIOR TO THE START OF ANY CONSTRUCTION ACTIVITY, IT SHALL BE THE CONTRACTOR'S RESPONSIBILITY TO NOTIFY THE VARIOUS UTILITIES AND TO MAKE THE NECESSARY ARRANGEMENTS FOR ANY RELOCATIONS TO THESE UTILITIES WITH THE OWNER OF THE UTILITY. THE CONTRACTOR SHALL EXERCISE CAUTION WHEN CROSSING AN UNDERGROUND UTILITY, WHETHER SHOWN ON THE PLANS OR LOCATED BY THE UTILITY COMPANY. ALL UTILITIES THAT INTERFERE WITH THE PROPOSED CONSTRUCTION SHALL BE RELOCATED. ANY COST, DELAY OR INCONVENIENCE CAUSED TO THE CONTRACTOR BY THE RELOCATION OF VARIOUS UTILITIES SHALL BE INCIDENTAL TO THE CONTRACT, AND NO EXTRA COMPENSATION WILL BE ALLOWED.

A SINGLE POINT UTILITY LOCATION SERVICE HAS BEEN SET UP FOR PARTICIPATING UTILITIES. THE CONTRACTOR IS TO CONTACT THE SUNSHINE STATE ONE CALL CENTER AT LEAST TWO (2) AND NO MORE THAN FIVE (5) WORKING DAYS PRIOR TO THE SPECIFIC CONSTRUCTION ACTIVITY FOR FIELD LOCATION. NOTE THAT NOT ALL UTILITIES PARTICIPATE IN THIS PROGRAM. THE CONTRACTOR SHOULD CONTACT NON-PARTICIPATING UTILITIES SEPARATELY FOR THEIR FIELD LOCATION OF FACILITIES. PER FLORIDA STATUTE 553.851, THE CONTRACTOR OR EXCAVATOR IS REQUIRED TO NOTIFY THE GAS COMPANY TWO (2) WORKING DAYS PRIOR TO STARTING EXCAVATION.

AS-BUILTS

THE CONTRACTOR SHALL PROVIDE AS-BUILT SURVEYED INFORMATION WITH NORTHING AND EASTING DATA FOR ALL VALVES, FITTINGS, AND EVERY 100 FEET OF PIPE. VERTICAL DATA SHALL BE PROVIDED AT ALL VALVES.

PERMITS AND PERMIT REQUIREMENTS

THE CONTRACTOR SHALL OBTAIN FROM THE OWNER COPIES OF ALL REGULATORY AND LOCAL AGENCY PERMITS. THE CONTRACTOR SHALL BE EXPECTED TO REVIEW AND ABIDE BY ALL THE REQUIREMENTS AND LIMITATIONS SET FORTH IN THE PERMITS.

THE CONTRACTOR SHALL BE FURNISHED A COPY OF THE N.P.D.E.S. NOTICE OF INTENT APPLICATION AND REPORT WHICH WAS FURNISHED TO EPA BY THE OWNER. THE CONTRACTOR SHALL REVIEW THE CONTENTS OF THAT SUBMITTAL INCLUDING CONSTRUCTION COMMENCEMENT AND CESSATION DATES AND ALL OTHER ELEMENTS OF THE SUBMITTAL. HE SHALL EXECUTE AND FILE AN N.O.I. TO EPA AS THE ENTITY RESPONSIBLE FOR OPERATING AND MAINTAINING THE EROSION PROTECTION SYSTEM DURING CONSTRUCTION, NOTING ANY CHANGES AND/OR MODIFICATIONS AND/OR AGREEING TO THE ELEMENTS OF THE ORIGINAL SUBMITTAL. HE SHALL SUBMIT THIS AT LEAST 48 HOURS PRIOR TO COMMENCING CONSTRUCTION. THE CONTRACTOR SHALL KEEP ON-SITE A COPY OF THE WATER MANAGEMENT DISTRICT AND N.P.D.E.S. PERMITS ISSUED TOGETHER WITH THE INSPECTION REPORTS AND CURRENT PLANS, INCLUDING ANY MODIFICATIONS REQUIRED. HE SHALL ALSO PROVIDE A NOTICE OF TERMINATION TO THE N.P.D.E.S. PERMITTING AUTHORITY AT THE CONCLUSION OF THE PROJECT THAT THE DISCHARGE AND EROSION PROTECTION DEVICE AS SHOWN ON THE PLANS HAVE BEEN IMPLEMENTED AND MAINTAINED THROUGHOUT CONSTRUCTION.

QUALITY CONTROL TESTING REQUIREMENTS

ALL TESTING RESULTS SHALL BE PROVIDED TO THE OWNER/OPERATOR, COUNTY, AND THE ENGINEER. TESTING REQUIREMENTS ARE TO BE IN ACCORDANCE WITH THE OWNER/OPERATOR'S SPECIFICATIONS AND REQUIREMENTS. ALL TEST RESULTS SHALL BE PROVIDED (PASSING AND FAILING) ON A REGULAR AND IMMEDIATE BASIS. CONTRACTOR SHALL PROVIDE TESTING SERVICES THROUGH A FLORIDA LICENSED GEOTECHNICAL ENGINEERING FIRM ACCEPTABLE TO THE OWNER AND ENGINEER. NO TESTING TO BE SCHEDULED ON MONDAY OR FRIDAY.

SHOP DRAWINGS

THE CONTRACTOR SHALL SUBMIT SHOP DRAWINGS TO THE ENGINEER FOR APPROVAL PRIOR TO ORDERING THE MATERIALS REQUIRED FOR CONSTRUCTION.

EARTHWORK

EARTHWORK QUANTITIES

THE CONTRACTOR SHALL PERFORM HIS OWN INVESTIGATIONS AND CALCULATIONS AS NECESSARY TO ASSURE HIMSELF OF EARTHWORK QUANTITIES. THERE IS NO IMPLICATION THAT EARTHWORK BALANCES AND THE CONTRACTOR SHALL BE RESPONSIBLE FOR ANY IMPORT FILL NEEDED, OR FOR REMOVAL AND DISPOSAL OF EXCESS MATERIALS.

EROSION CONTROL

EROSION AND SILTATION CONTROL MEASURES ARE TO BE PROVIDED AND INSTALLED PRIOR TO COMMENCEMENT OF CONSTRUCTION. THESE MEASURES ARE TO BE INSPECTED BY THE CONTRACTOR ON A REGULAR BASIS AND ARE TO BE MAINTAINED OR REPAIRED ON AN IMMEDIATE BASIS, AS REQUIRED. REFER TO ST. JOHNS RIVER WATER MANAGEMENT DISTRICT PERMIT FOR ADDITIONAL REQUIREMENTS FOR EROSION CONTROL AND SURFACE DRAINAGE.

WETLAND PROTECTION

THE LIMITS OF THE ON-SITE WETLANDS HAVE BEEN PROVIDED TO THE CONTRACTOR ON THE CONSTRUCTION PLANS OR ON PERMIT MATERIALS. THE WETLANDS AREAS ARE TO BE PROTECTED FROM DISTURBANCE AT ALL TIMES. CONTRACTOR SHALL PROVIDE EROSION, SILTATION, AND DIVERSION MEASURES PRIOR TO COMMENCEMENT OF CONSTRUCTION. THE CONTRACTOR SHALL OBTAIN A COPY OF EACH PERMIT RELATING TO WETLANDS AND ADHERE TO ALL PROVISIONS AND CONDITIONS THERETO.

LIMITS OF DISTURBANCE

AT NO TIME SHALL THE CONTRACTOR DISTURB SURROUNDING PROPERTIES OR TRAVEL ON SURROUNDING PROPERTIES WITHOUT WRITTEN CONSENT FROM THE PROPERTY OWNER. REPAIR OR RECONSTRUCTION OF DAMAGED AREAS ON SURROUNDING PROPERTIES SHALL BE PERFORMED BY THE CONTRACTOR ON AN IMMEDIATE BASIS. ALL COSTS FOR REPAIRS SHALL BE THE RESPONSIBILITY OF THE CONTRACTOR AND NO EXTRA COMPENSATION SHALL BE PROVIDED.

TREE REMOVAL

THE CONTRACTOR SHALL NOTIFY THE OWNER AND ENGINEER WHEN ALL WORK IS LAID OUT (SURVEY STAKED), SO THAT A DETERMINATION MAY BE MADE OF SPECIFIC TREES TO BE REMOVED. NO TREES SHOWN ON THE CONSTRUCTION PLANS AS BEING SAVED SHALL BE REMOVED WITHOUT PERMISSION FROM THE OWNER AND ENGINEER.

CLEARING AND GRUBBING

THE CONTRACTOR SHALL BE RESPONSIBLE FOR CLEARING AND GRUBBING FOR SITE CONSTRUCTION INCLUDING CLEARING FOR PAVING, UTILITIES, DRAINAGE FACILITIES AND BUILDING CONSTRUCTION. SEE PLANS FOR LIMITS OF CLEARING AND GRUBBING. ALL AREAS TO BE CLEARED SHALL BE FIELD STAKED AND REVIEWED BY THE OWNER AND ENGINEER PRIOR TO ANY CONSTRUCTION.

MATERIAL STORAGE / DEBRIS REMOVAL

ALL MATERIALS EXCAVATED SHALL REMAIN THE PROPERTY OF THE OWNER AND SHALL BE STOCKPILED AT ON-SITE LOCATIONS AS SPECIFIED BY THE OWNER. MATERIALS SHALL BE STOCKPILED SEPARATELY AS TO USABLE (NON ORGANIC) FILL STOCKPILES AND ORGANIC (MUCK) STOCKPILES IF MUCK IS ENCOUNTERED. CONTRACTOR SHALL BE RESPONSIBLE FOR THE REMOVAL OF ALL UNSUITABLE FILL MATERIALS FROM THE SITE. ALL CLAY ENCOUNTERED SHALL BE EXCAVATED OUT AND REPLACED WITH CLEAN GRANULAR FILL MATERIALS.

FILL MATERIAL

ALL FILL MATERIALS SHALL NOT CONTAIN MUCK, STUMPS, ROOTS, BRUSH, VEGETATIVE MATTER, RUBBISH OR OTHER MATERIAL THAT WILL NOT COMPACT INTO A SUITABLE AND ENDURING BACKFILL. FILL SHALL BE CLEAN, NON-ORGANIC, GRANULAR MATERIAL WITH NOT MORE THAN 10% PASSING THE NO. 200 SIEVE.

COMPACTION

FILL MATERIALS PLACED UNDER ROADWAYS SHALL BE COMPACTED TO AT LEAST 98% OF THE MAXIMUM DENSITY AS SPECIFIED IN AASHTO T-180. ALL OTHER FILL AREAS ARE TO BE COMPACTED TO AT LEAST 95% MAXIMUM DENSITY AS SPECIFIED IN AASHTO T-180. FILL MATERIALS SHALL BE PLACED AND COMPACTED IN A MAXIMUM OF 12" LIFTS. THE CONTRACTOR SHALL PROVIDE THE ENGINEER AND OWNER WITH ALL (PASSING AND FAILING) TESTING RESULTS. RESULTS SHALL BE PROVIDED ON A TIMELY AND REGULAR BASIS PRIOR TO CONTRACTOR'S PAY REQUEST SUBMITTAL FOR THE AFFECTED WORK.

FORCE MAIN

OWNER/OPERATOR

THE ENTITY THAT WILL OWN, OPERATE AND MAINTAIN THE FORCE MAIN SHOWN ON THESE PLANS IS UTILITIES INC. OF FLORIDA. THE CONTRACTOR SHALL BE EXPECTED TO MEET ALL THE REQUIREMENTS OF THAT ENTITY.

MATERIALS

SANITARY SEWER FORCE MAIN SHALL BE POLYVINYL CHLORIDE PLASTIC PIPE (PVC) AND SHALL CONFORM TO ASTM D2241 PLASTIC PIPE (SD PR & CLASS T), ASTM 1784, TYPE I, 2000 PSI DESIGN STRESS. THE PIPE SHALL BE ANSI/AWWA C900, WITH MARKINGS ON EACH SECTION SHOWING CONFORMANCE WITH THE ABOVE SPECIFICATION. JOINTS SHALL BE ELASTOMERIC RUBBER GASKETED CONFORMING TO ASTM D3139 DR 18 PIPE.

FITTINGS FOR FORCE MAIN SHALL BE MECHANICAL JOINT, DUCTILE IRON CONFORMING TO ANSI/AWWA C110/A21.10 350 PSI MINIMUM PRESSURE RATING. FITTINGS SHALL BE POLYETHYLENE LINED (MIN. 30 MILS CONFORMING TO ASTM D-1248).

ALL PLUGS, CAPS, TEES, VALVES, BENDS, ETC., SHALL BE RESTRAINED JOINTS OR THRUST BLOCKED (RESTRAINED JOINT PREFERED) PER DETAILS ON UTILITY SHEETS. THREE FOOT MINIMUM COVER OVER FORCE MAIN.

STANDARD PLUG VALVES SHALL BE MANUFACTURED BY DEZURIK CORP., PRATT, DRESSER, HOMESTEAD INDUSTRIES, OR APPROVED EQUAL.

VALVES SHALL BE FURNISHED WITH A REPLACEABLE CHEVRON PACKING, CAPABLE OF BEING REPACKED WITH THE LINE UNDER PRESSURE.

VALVES 4 INCHES IN DIAMETER AND SMALLER SHALL BE WRENCH NUT OPERATED. VALVES LARGER THAN 4 INCHES SHALL BE WORM GEAR OPERATED, EXCEPT WHERE AUTOMATIC OPERATION IS SPECIFIED.

AIR RELEASE VALVE DESIGNED FOR SEWAGE SERVICE SHALL BE INSTALLED IN THE TOPS OF PIPES AS INDICATED ON THE DRAWINGS. VALVES SHALL BE DESIGNED TO PERMIT MANUAL RELEASE OF AIR FROM AN EMPTY PIPE DURING FILLING AND SHALL BE CAPABLE OF DISCHARGING ACCUMULATED AIR IN THE LINE WHILE THE LINE IS IN OPERATION AND UNDER PRESSURE. VALVES SHALL BE CAPABLE OF WITHSTANDING OPERATING PRESSURES OF 50 PSI. VALVES SHALL BE VENTED TO THE ATMOSPHERE. THE VALVES SHALL BE VALMATIC, OR APPROVED EQUAL.

CHECK VALVES SHALL BE OF THE WEIGHT AND LEVER TYPE, RESILIENT DISK, GRAY IRON, BRONZE TRIM, HORIZONTAL MOUNTED. VALVES SHALL BE MANUFACTURED IN ACCORDANCE WITH AWWA C508 WITH FLANGED CONNECTIONS. VALVES SHALL HAVE A WORKING PRESSURE OF 200 PSI FOR VALVES 2"-12". VALVES SHALL BE DEZURIK, MUELLER, OR APPROVED EQUAL.

CONSTRUCTION METHODS

TRENCHING SHALL BE IN ACCORDANCE WITH THE TRENCHING DETAILS PROVIDED ON THE CONSTRUCTION PLANS.

COMPACTED BACKFILL FOR ALL PIPE SHALL BE TO 98% MAXIMUM DENSITY AS DETERMINED BY AASHTO T-180 FOR UNDER ROADWAYS. OTHER COMPACTION OF BACKFILL SHALL BE TO THE 95% MAXIMUM DENSITY AS DETERMINED BY AASHTO T-180.

INSTALLATION OF THE SANITARY SEWER FORCE MAIN SHALL BE IN CONFORMANCE WITH ASTM D2774-72 (LATEST EDITION).

MINIMUM COVER OVER ALL PIPES SHALL BE 36" FROM TOP OF PIPE TO FINISHED GRADE. SEE PLAN AND PROFILE SHEETS FOR REQUIRED DEPTH.

THE FORCE MAIN SHALL BE INSTALLED AS NOTED ON THE PLANS. WHERE APPLICABLE, A LATERAL SEPARATION OF AT LEAST 10' SHALL BE MAINTAINED BETWEEN WATER AND SEWER LINES. WHEN WATER AND SEWER LINES CROSS WITH LESS THAN AN 18" VERTICAL SEPARATION, THE PVC SEWER LINE SHALL BE ENCASED IN CONCRETE OR DUCTILE IRON PIPE USED IN LIEU OF PVC PIPE FOR A DISTANCE OF 10' EITHER SIDE OF THE CROSSING.

ALL PLUGS, CAPS, TEES, BENDS, VALVES, ETC., SHALL BE PROVIDED WITH RESTRAINED JOINTS OR THRUST BLOCKS (RESTRAINED JOINTS PREFERRED) PER UTILITY DETAIL SHEET.

GREEN MAGNETIC INDICATOR TAPE SHALL BE BURIED IN THE FORCE MAIN TRENCH 18" DIRECTLY ABOVE THE FORCE MAIN. A CONTINUOUS COPPER DETECTOR WIRE SHALL BE ATTACHED TO THE PIPE AND VALVES AS SHOWN ON THE UTILITY SHEETS.

CONNECTIONS TO MANHOLE WITH FORCE MAINS SHALL BE MADE BY CORE BORE AND LINK SEAL OR OTHER APPROVED CONNECTION. CONNECTIONS SHALL BE MADE WATERTIGHT AND BE INSTALLED ACCORDING TO THE MANUFACTURERS' RECOMMENDATIONS.

TESTING

FORCE MAIN SHALL BE PRESSURE AND LEAKAGE TESTED IN ACCORDANCE WITH AWWA STANDARD M23. FORCE MAIN SYSTEM SHALL BE TESTED FOR TWO (2) HOURS AT 100 PSI. SEVENTY-TWO (72) HOURS WRITTEN ADVANCE NOTIFICATION TO THE ENGINEER AND THE UTILITY COMPANY OF THE TESTING WILL BE REQUIRED. NO TESTING ON MONDAY OR FRIDAY. THE CONTRACTOR SHALL PERFORM SATISFACTORY PROTESTING PRIOR TO NOTIFICATION.

AS-BUILT DRAWINGS

THE CONTRACTOR SHALL PROVIDE VERTICAL AND HORIZONTAL "AS-BUILT" INFORMATION RELATIVE TO ALL CONSTRUCTED UTILITIES AND STRUCTURES.



AS-BUILT INFORMATION FOR THE FORCE MAIN SHALL INCLUDE, BUT NOT BE LIMITED TO, THE FOLLOWING

1. LOCATION OF ALL VALVES, FITTINGS, ETC.
2. LOCATION OF THE FORCE MAIN TIED HORIZONTALLY TO THE BACK OF CURB OR EDGE OF PAVEMENT.
3. CERTIFICATION AS TO THE SYSTEM MEETING THE MINIMUM COVER REQUIREMENTS.
4. HORIZONTAL AND VERTICAL DATA FOR ANY CONSTRUCTION WHICH DEVIATES FROM THE APPROVED ENGINEERING DRAWINGS.



				<p>© 2016 KIMLEY-HORN AND ASSOCIATES, INC. 3660 MAGUIRE BOULEVARD, SUITE 200, ORLANDO, FL 32803 PHONE: 407-898-1511 WWW.KIMLEY-HORN.COM CA 00000696</p>	<p>KHA PROJECT 149685007</p> <p>DATE 11/7/16</p> <p>SCALE AS SHOWN</p> <p>DESIGNED BY SNR</p> <p>DRAWN BY JIH</p> <p>CHECKED BY NEQ</p>	<p>SPRINGS BLVD FORCE MAIN</p>	<p>LICENSED PROFESSIONAL</p> <p>STEPHEN N. ROMANO, P.E.</p> <p>57579</p> <p>DATE: -----</p>	<p>GENERAL NOTES</p>	<p>SHEET NUMBER</p> <p>2</p>
No.	REVISIONS	DATE	BY						

This document, together with the concepts and designs presented herein, is intended only for the specific purpose and client for which it was prepared. Reuse of any information contained herein, in whole or in part, without the written authorization and approval of Kimley-Horn and Associates, Inc. shall be without liability to Kimley-Horn and Associates, Inc.

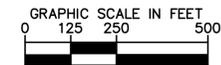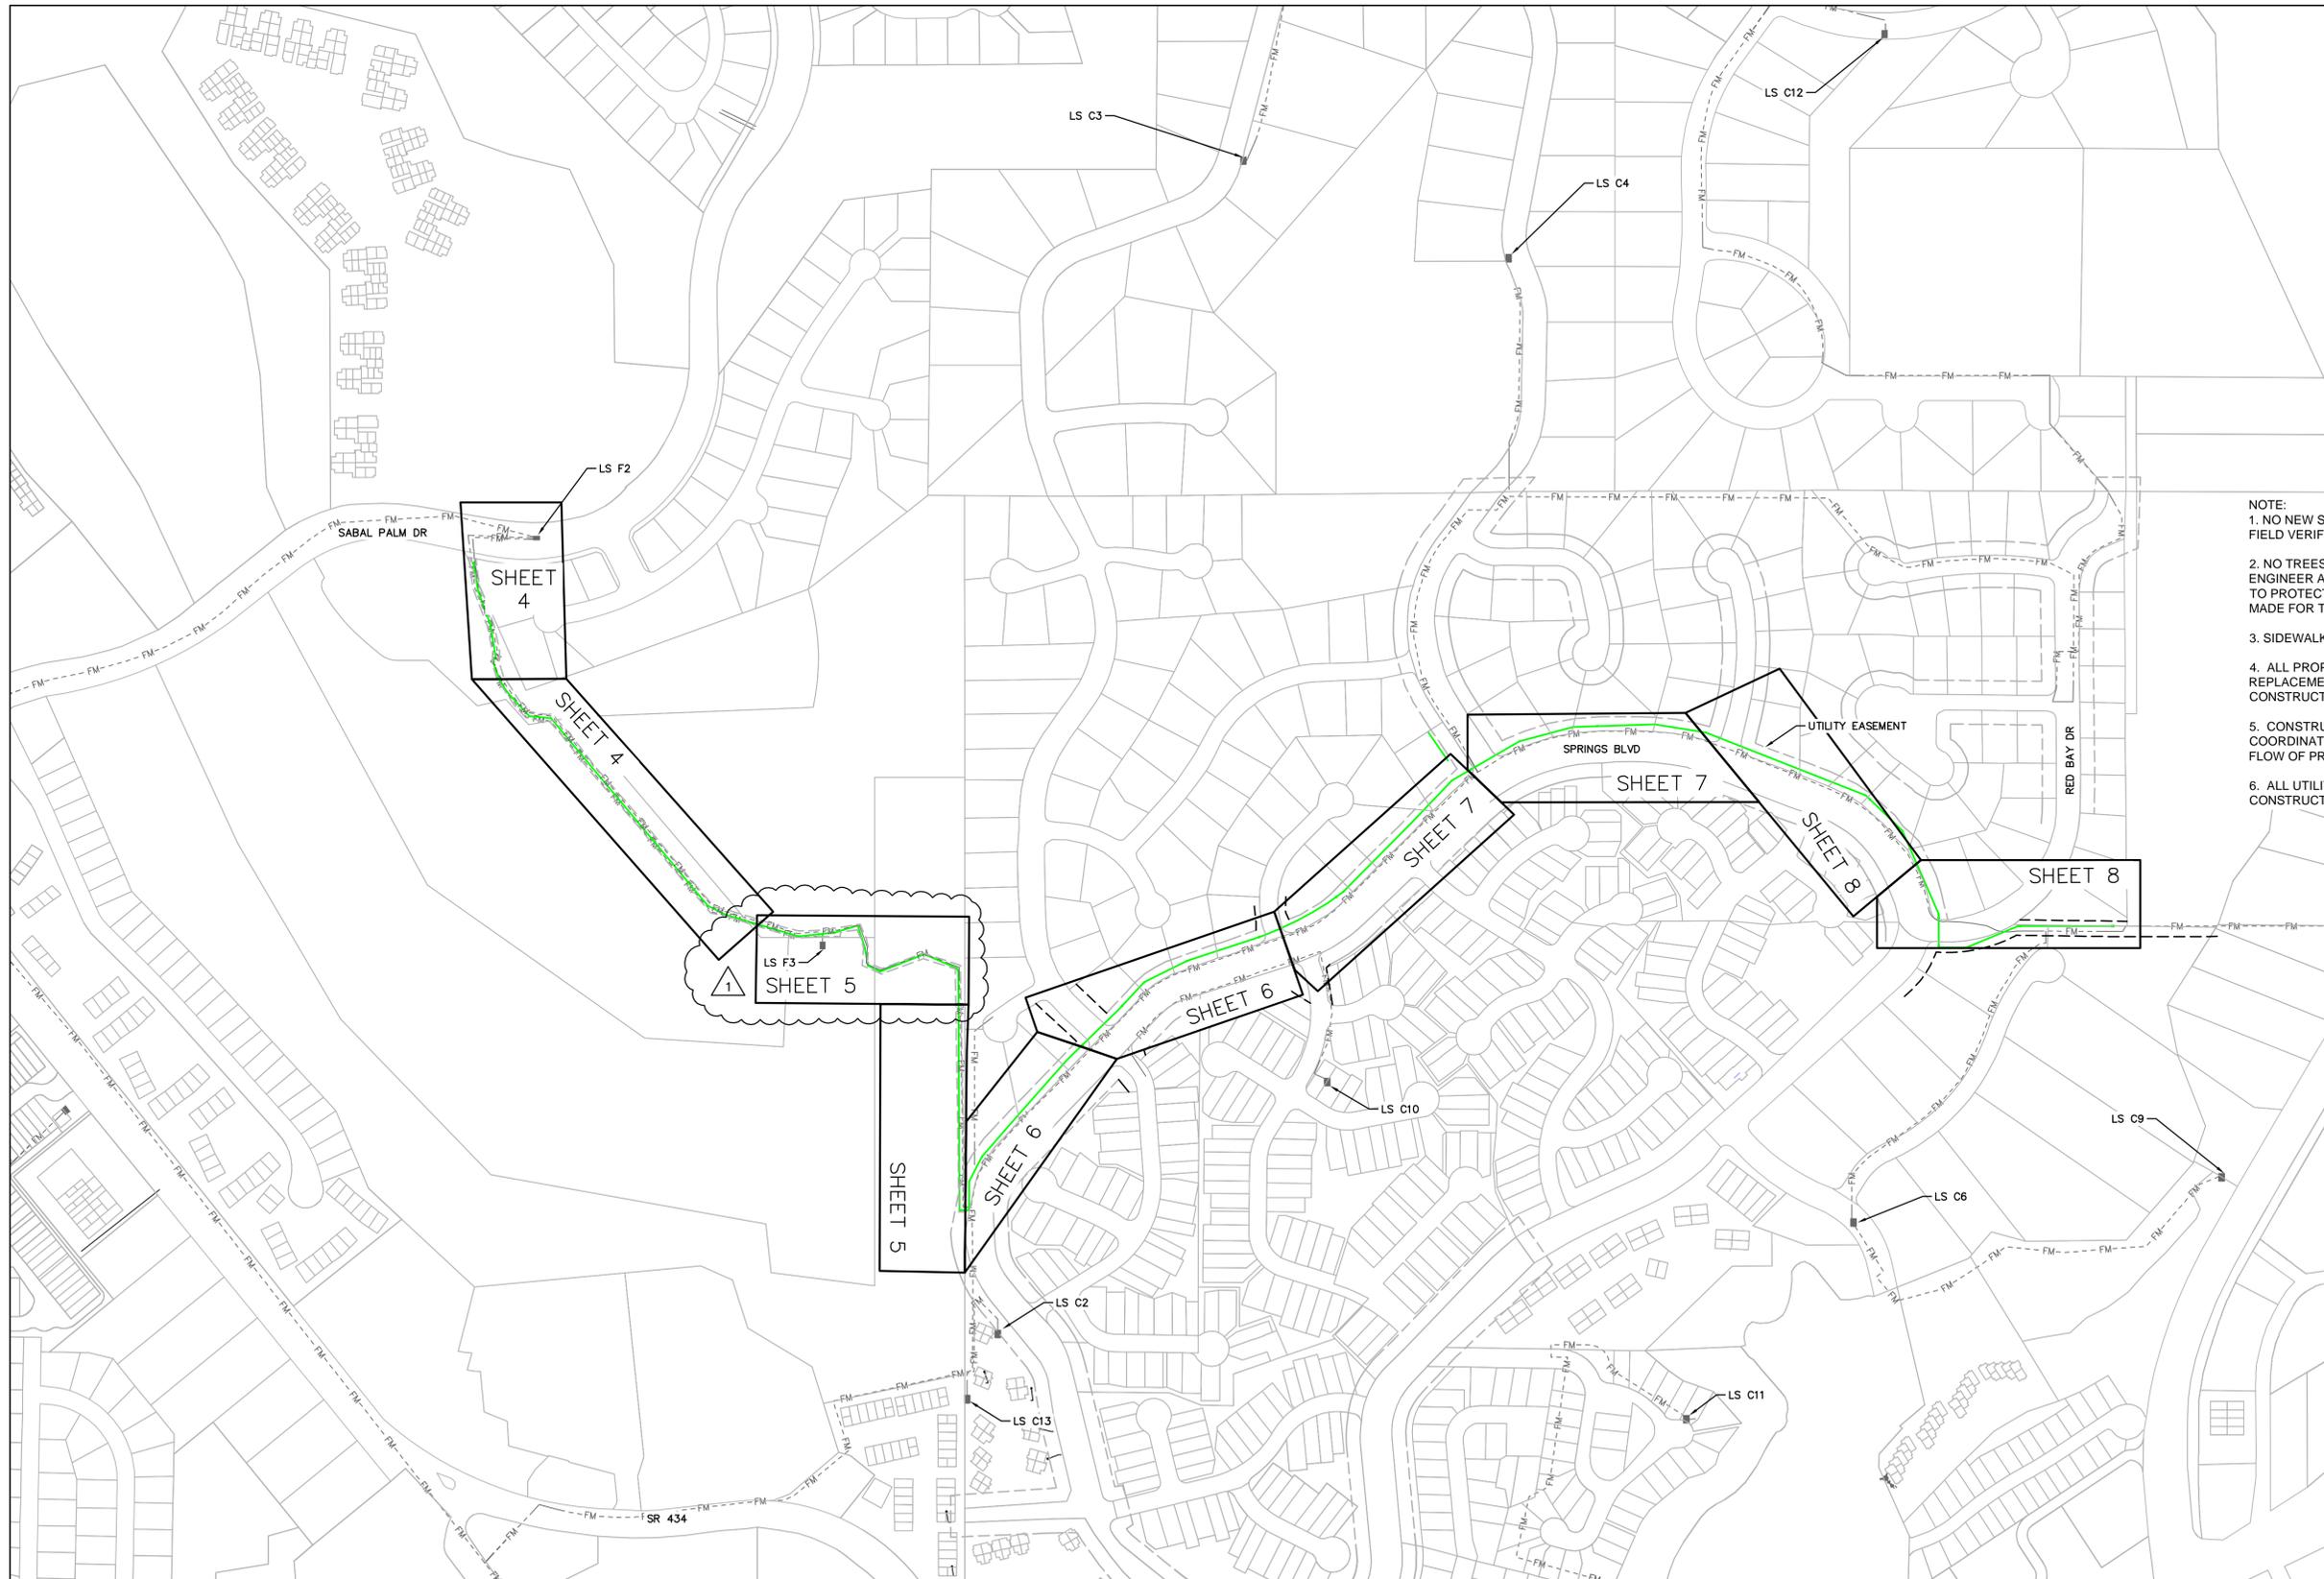

LEGEND

- EXISTING WATER MAIN
- - - FM - - - EXISTING FORCE MAIN
- - - S - - - EXISTING SANITARY SEWER
- - - U - - - UTILITY EASEMENT
- FM --- PROPOSED FORCE MAIN
- ⊗ AIR RELEASE VALVE
- ⊕ PLUG VALVE

- NOTE:**
1. NO NEW SURVEY WAS OBTAIN FOR THIS PROJECT. CONTRACTOR MUST FIELD VERIFY LOCATIONS OF EXISTING UTILITIES
 2. NO TREES SHALL BE REMOVED UNLESS SPECIFICALLY ALLOWED BY THE ENGINEER AND COUNTY R.O.W. PERMIT. ALIGNMENT MAY BE ADJUSTED TO PROTECT EXIST. TREES. NO ADDITIONAL COMPENSATION WILL BE MADE FOR THESE ADJUSTMENTS.
 3. SIDEWALK MAY BE REMOVED AND REPLACED AS NECESSARY.
 4. ALL PROPERTY OWNERS WHOSE DRIVEWAYS REQUIRED REPLACEMENT WILL BE INDIVIDUALLY CONTACTED PRIOR TO CONSTRUCTION.
 5. CONSTRUCTION ACTIVITIES WITHIN 2 MILES OF A SCHOOL WILL BE COORDINATED WITH THE SCHOOL TO ENSURE THE SAFE CONTINUOUS FLOW OF PROPER PEDESTRIAN TRAFFIC FOR SCHOOL CHILDREN.
 6. ALL UTILITIES WILL BE PHYSICALLY VERIFIED PRIOR TO CONSTRUCTION.

Always call 811 two full business days before you dig to have underground utilities located and marked.



1	ADDENDUM 1		11/18/16	RL	
No.	REVISIONS	DATE	BY		



© 2016 KIMLEY-HORN AND ASSOCIATES, INC.

3660 MAGUIRE BOULEVARD, SUITE 200, ORLANDO, FL 32803
PHONE: 407-898-1511
WWW.KIMLEY-HORN.COM CA 0000696

KHA PROJECT
149685007
DATE
11/7/16
SCALE AS SHOWN
DESIGNED BY SNR
DRAWN BY JIH
CHECKED BY NEQ


SPRINGS BLVD FORCE MAIN

LICENSED PROFESSIONAL
STEPHEN N. ROMANO, P.E.
57579
DATE: _____


KEY SHEET

SHEET NUMBER
3


This document, together with the concepts and designs presented herein, is intended only for the specific purpose and client for which it was prepared. Review of any improper reliance on this document without written authorization and adaptation by Kimley-Horn and Associates, Inc. shall be without liability to Kimley-Horn and Associates, Inc.

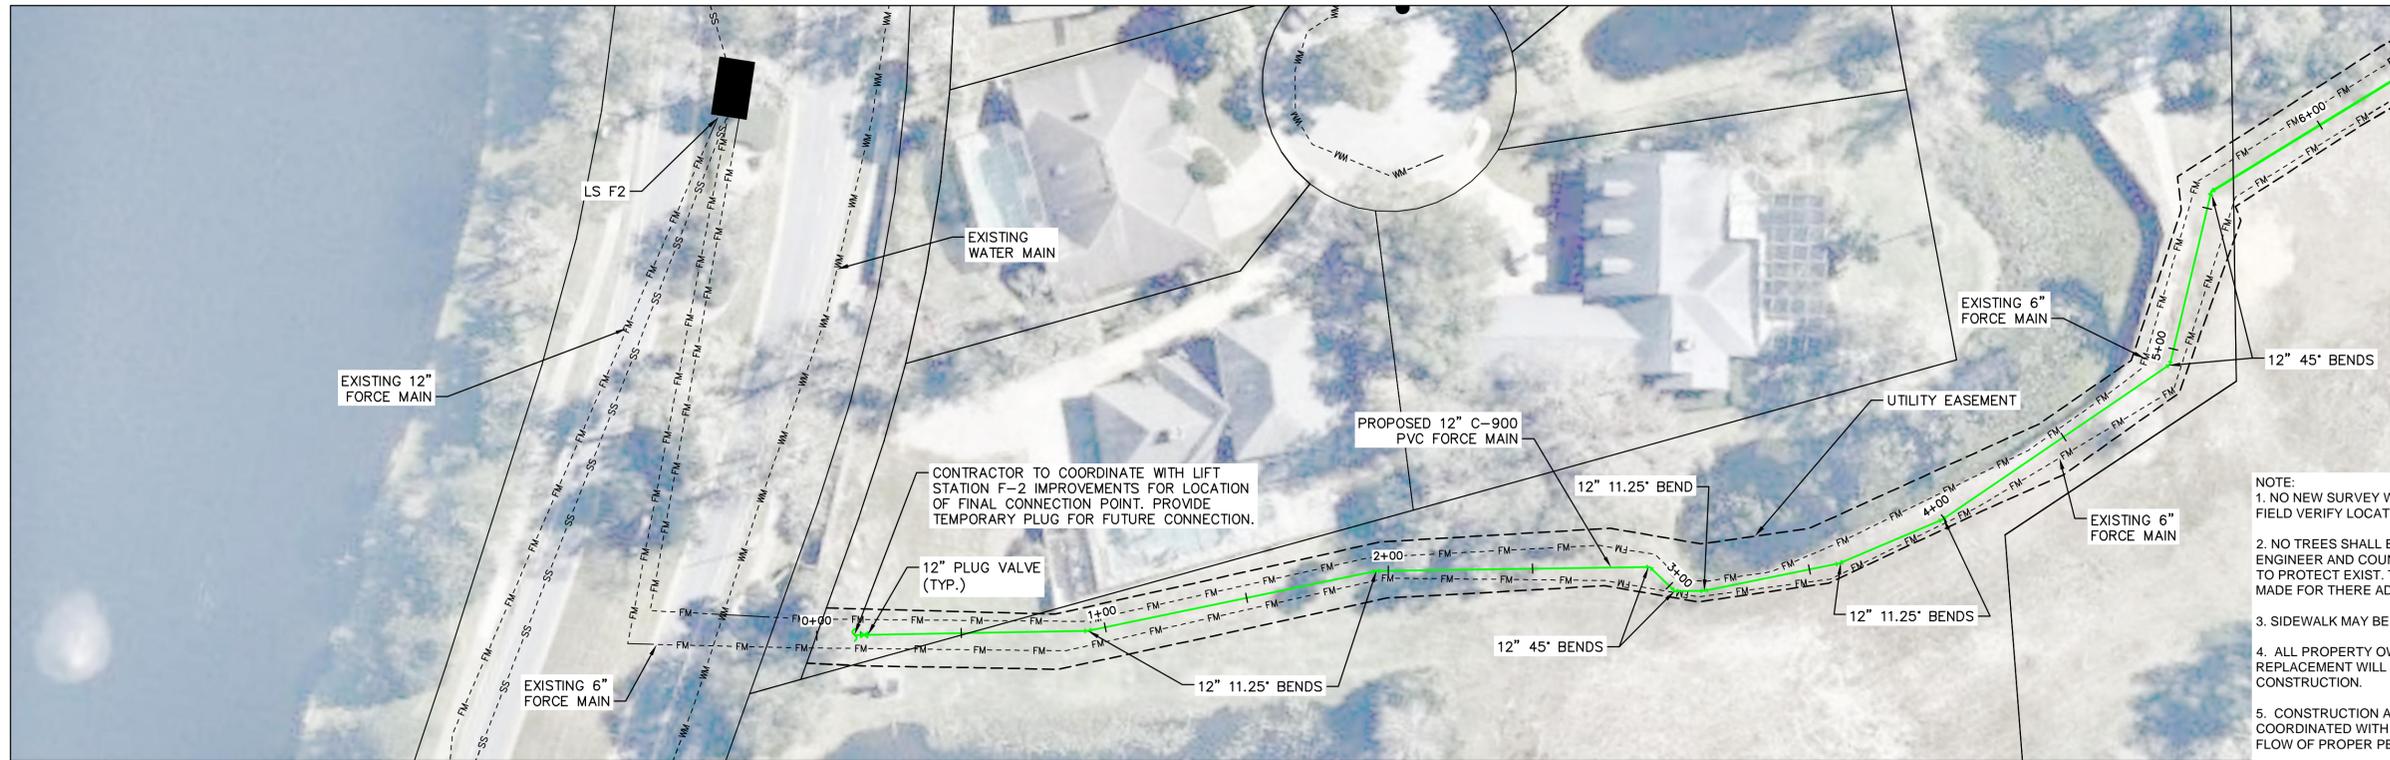


MATCH STA. 6+25 THIS SHEET BELOW

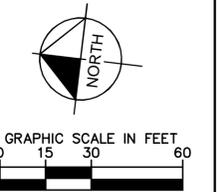

- NOTE:
1. NO NEW SURVEY WAS OBTAIN FOR THIS PROJECT. CONTRACTOR MUST FIELD VERIFY LOCATIONS OF EXISTING UTILITIES
 2. NO TREES SHALL BE REMOVED UNLESS SPECIFICALLY ALLOWED BY THE ENGINEER AND COUNTY R.O.W. PERMIT. ALIGNMENT MAY BE ADJUSTED TO PROTECT EXIST. TREES. NO ADDITIONAL COMPENSATION WILL BE MADE FOR THESE ADJUSTMENTS.
 3. SIDEWALK MAY BE REMOVED AND REPLACED AS NECESSARY.
 4. ALL PROPERTY OWNERS WHOSE DRIVEWAYS REQUIRED REPLACEMENT WILL BE INDIVIDUALLY CONTACTED PRIOR TO CONSTRUCTION.
 5. CONSTRUCTION ACTIVITIES WITHIN 2 MILES OF A SCHOOL WILL BE COORDINATED WITH THE SCHOOL TO ENSURE THE SAFE CONTINUOUS FLOW OF PROPER PEDESTRIAN TRAFFIC FOR SCHOOL CHILDREN.
 6. ALL UTILITIES WILL BE PHYSICALLY VERIFIED PRIOR TO CONSTRUCTION.

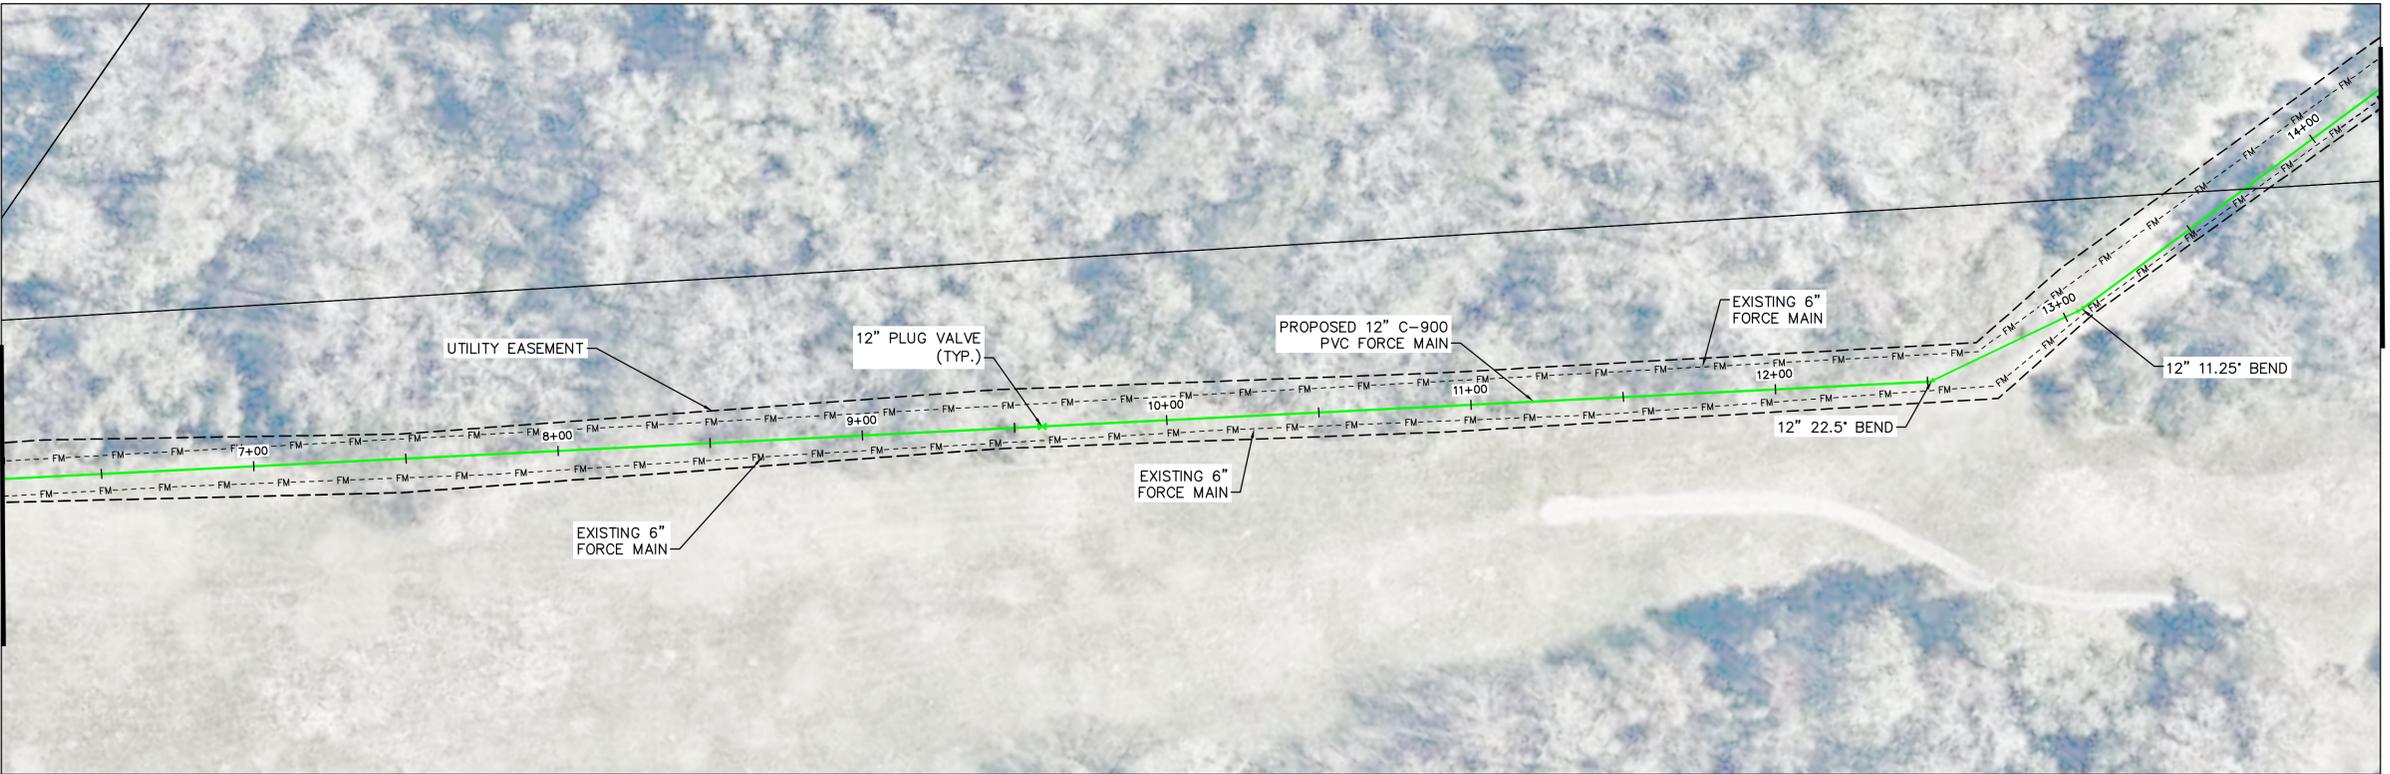

MATCH STA. 14+25 SHEET 5

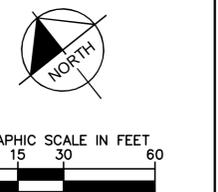

- LEGEND
- EXISTING WATER MAIN
 - - - FM - - - EXISTING FORCE MAIN
 - - - S - - - EXISTING SANITARY SEWER
 - - - UTILITY EASEMENT
 - PROPOSED FORCE MAIN
 - ⊗ AIR RELEASE VALVE
 - ⊕ PLUG VALVE

Always call 811 two full business days before you dig to have underground utilities located and marked.

No.	REVISIONS	DATE	BY

© 2016 KIMLEY-HORN AND ASSOCIATES, INC.
 3660 MAGUIRE BOULEVARD, SUITE 200, ORLANDO, FL 32803
 WWW.KIMLEY-HORN.COM CA 00000696

KHA PROJECT
149685007
 DATE
11/7/16
 SCALE AS SHOWN
 DESIGNED BY SNR
 DRAWN BY JIH
 CHECKED BY NEQ

SPRINGS BLVD FORCE MAIN

LICENSED PROFESSIONAL
 STEPHEN N. ROMANO, P.E.
 57579
 DATE: _____


STA 00+00 TO 14+25

SHEET NUMBER
4

This document, together with the concepts and designs presented herein, is intended only for the specific purpose and client for which it was prepared. Reuse of any information on this document without written authorization and adaptation by Kimley-Horn and Associates, Inc. shall be without liability to Kimley-Horn and Associates, Inc.





MATCH STA. 21+95 THIS SHEET BELOW

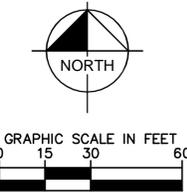

- NOTE:
1. NO NEW SURVEY WAS OBTAIN FOR THIS PROJECT. CONTRACTOR MUST FIELD VERIFY LOCATIONS OF EXISTING UTILITIES
 2. NO TREES SHALL BE REMOVED UNLESS SPECIFICALLY ALLOWED BY THE ENGINEER AND COUNTY R.O.W. PERMIT. ALIGNMENT MAY BE ADJUSTED TO PROTECT EXIST. TREES. NO ADDITIONAL COMPENSATION WILL BE MADE FOR THERE ADJUSTMENTS.
 3. SIDEWALK MAY BE REMOVED AND REPLACED AS NECESSARY.
 4. ALL PROPERTY OWNERS WHOSE DRIVEWAYS REQUIRED REPLACEMENT WILL BE INDIVIDUALLY CONTACTED PRIOR TO CONSTRUCTION.
 5. CONSTRUCTION ACTIVITIES WITHIN 2 MILES OF A SCHOOL WILL BE COORDINATED WITH THE SCHOOL TO ENSURE THE SAFE CONTINUOUS FLOW OF PROPER PEDESTRIAN TRAFFIC FOR SCHOOL CHILDREN.
 6. ALL UTILITIES WILL BE PHYSICALLY VERIFIED PRIOR TO CONSTRUCTION.

MATCH STA. 30+30 SHEET 6

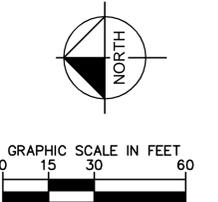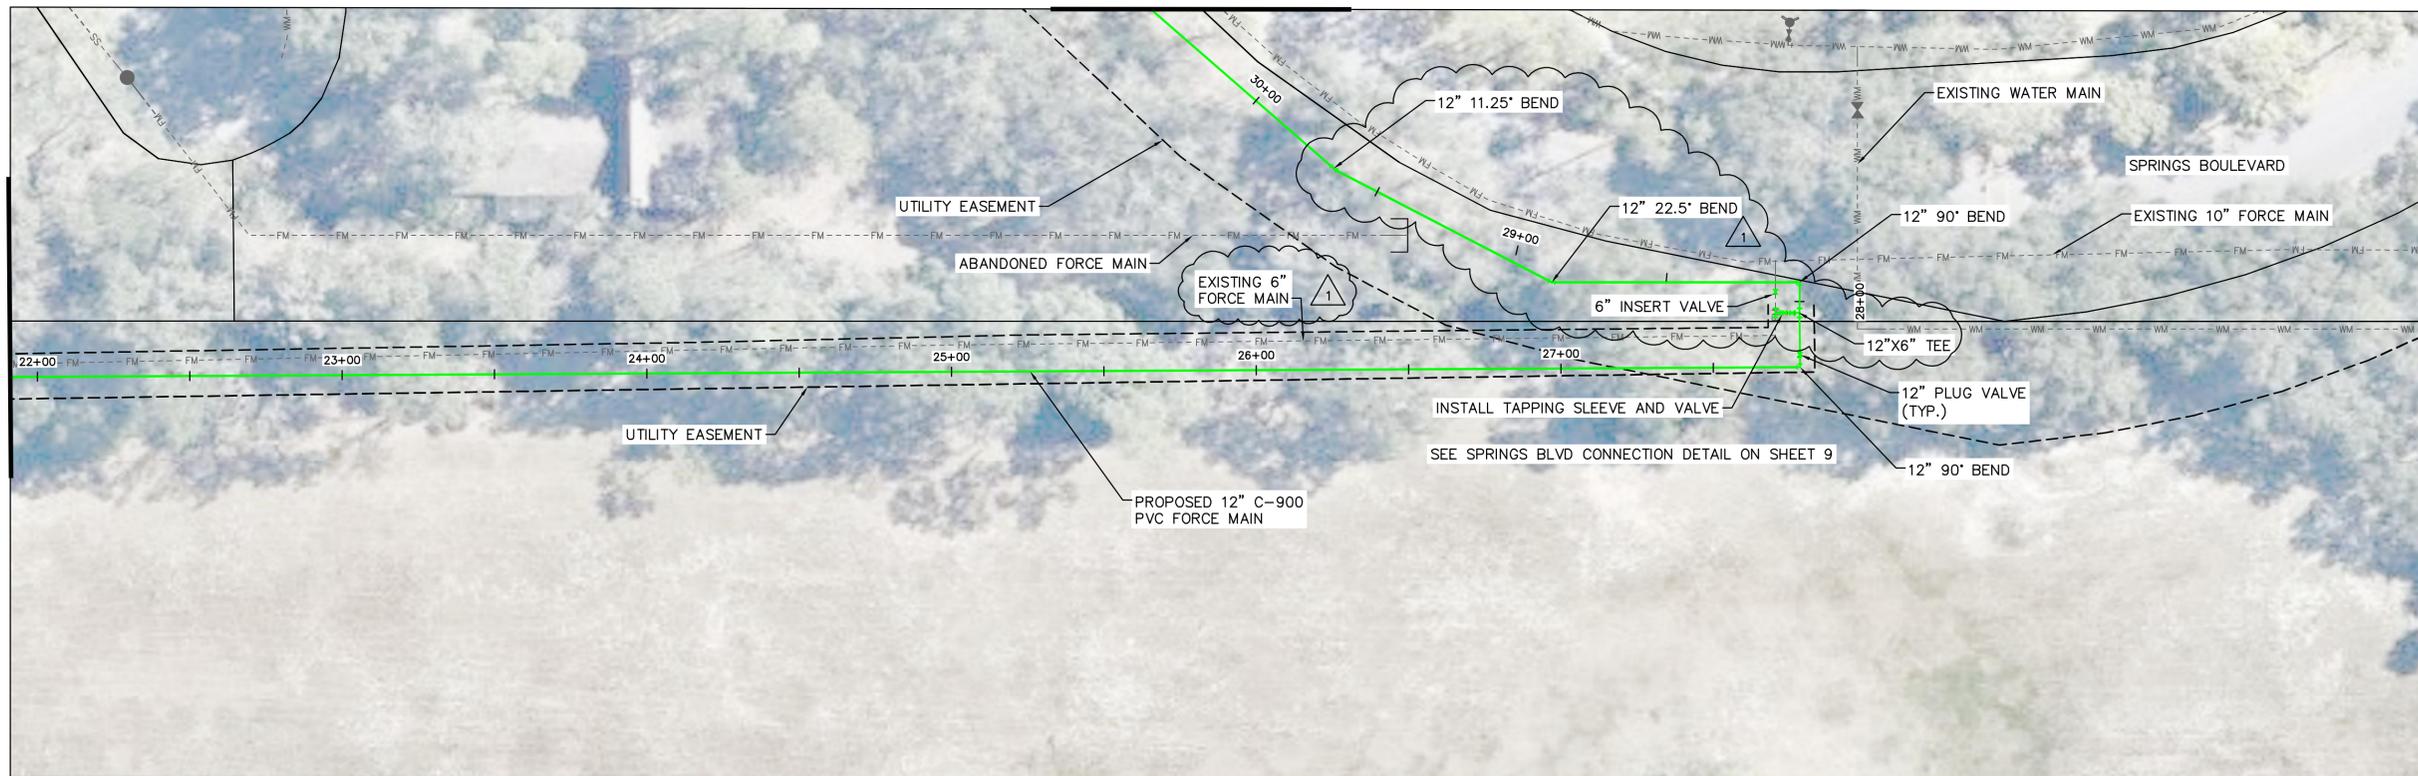

- LEGEND**
- WM --- EXISTING WATER MAIN
 - FM --- EXISTING FORCE MAIN
 - SS --- EXISTING SANITARY SEWER
 - U --- UTILITY EASEMENT
 - FM --- PROPOSED FORCE MAIN
 - ⊗ AIR RELEASE VALVE
 - ⊕ PLUG VALVE

Always call 811 two full business days before you dig to have underground utilities located and marked.

1	ADDENDUM 1	11/18/16	RL
No.	REVISIONS	DATE	BY

Kimley»Horn
 © 2016 KIMLEY-HORN AND ASSOCIATES, INC.
 3660 MAGUIRE BOULEVARD, SUITE 200, ORLANDO, FL 32803
 PHONE: 407-898-1511
 WWW.KIMLEY-HORN.COM CA 00000696

KHA PROJECT
149685007
 DATE
11/7/16
 SCALE AS SHOWN
 DESIGNED BY SNR
 DRAWN BY JIH
 CHECKED BY NEQ


SPRINGS BLVD FORCE MAIN

LICENSED PROFESSIONAL
 STEPHEN N. ROMANO, P.E.
 57579
 DATE: _____

STA 14+25 TO 30+30


SHEET NUMBER
5

This document, together with the concepts and designs presented herein, is intended only for the specific purpose and client for which it was prepared. Reuse of any improper reliance on this document without written authorization and adaptation by Kimley-Horn and Associates, Inc. shall be without liability to Kimley-Horn and Associates, Inc.

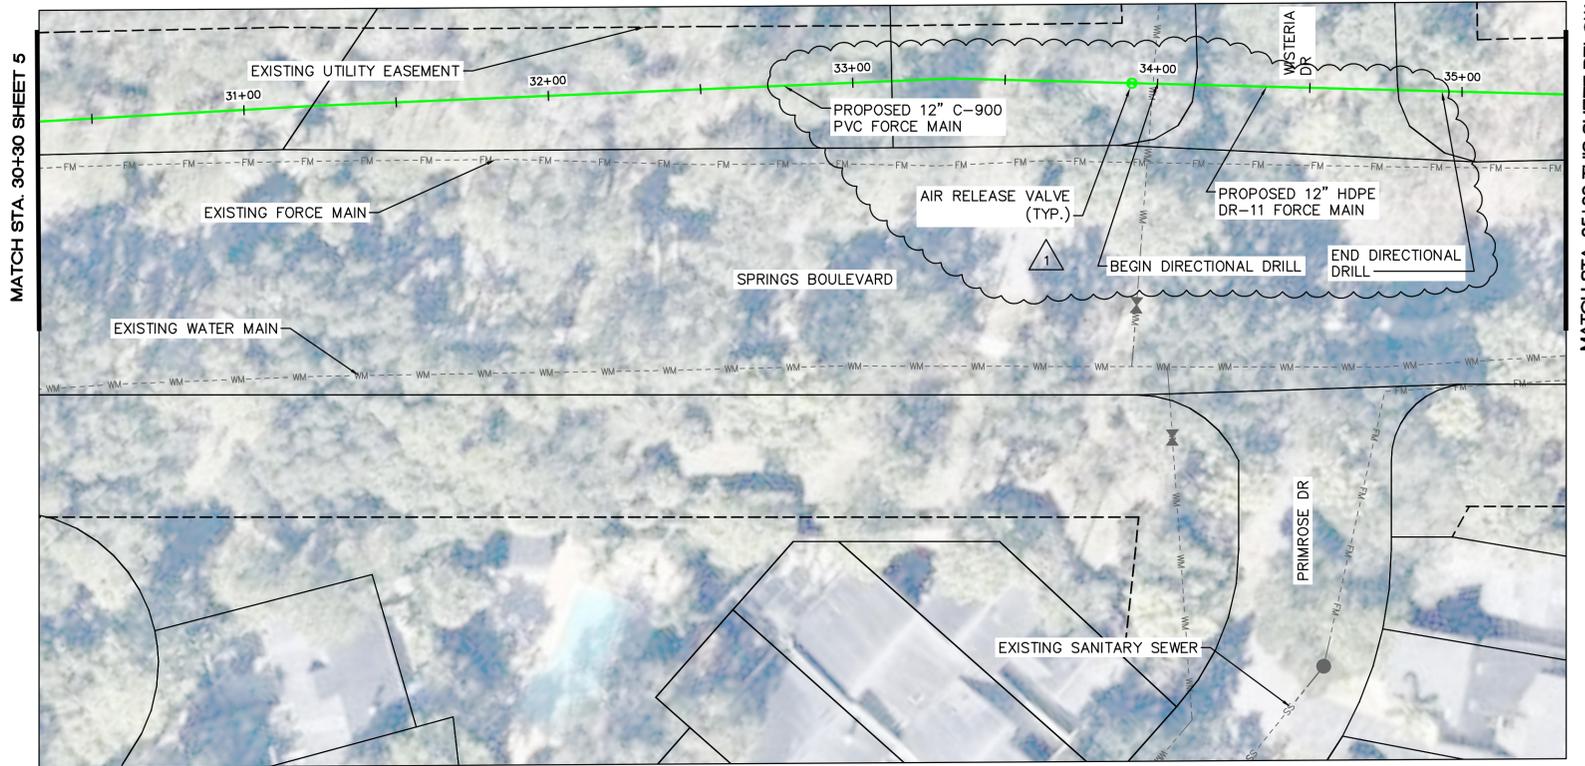


MATCH STA. 30+30 SHEET 5

MATCH STA. 35+30 THIS SHEET BELOW

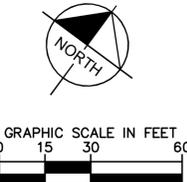


- NOTE:
1. NO NEW SURVEY WAS OBTAIN FOR THIS PROJECT. CONTRACTOR MUST FIELD VERIFY LOCATIONS OF EXISTING UTILITIES
 2. NO TREES SHALL BE REMOVED UNLESS SPECIFICALLY ALLOWED BY THE ENGINEER AND COUNTY R.O.W. PERMIT. ALIGNMENT MAY BE ADJUSTED TO PROTECT EXIST. TREES. NO ADDITIONAL COMPENSATION WILL BE MADE FOR THESE ADJUSTMENTS.
 3. SIDEWALK MAY BE REMOVED AND REPLACED AS NECESSARY.
 4. ALL PROPERTY OWNERS WHOSE DRIVEWAYS REQUIRED REPLACEMENT WILL BE INDIVIDUALLY CONTACTED PRIOR TO CONSTRUCTION.
 5. CONSTRUCTION ACTIVITIES WITHIN 2 MILES OF A SCHOOL WILL BE COORDINATED WITH THE SCHOOL TO ENSURE THE SAFE CONTINUOUS FLOW OF PROPER PEDESTRIAN TRAFFIC FOR SCHOOL CHILDREN.
 6. ALL UTILITIES WILL BE PHYSICALLY VERIFIED PRIOR TO CONSTRUCTION.

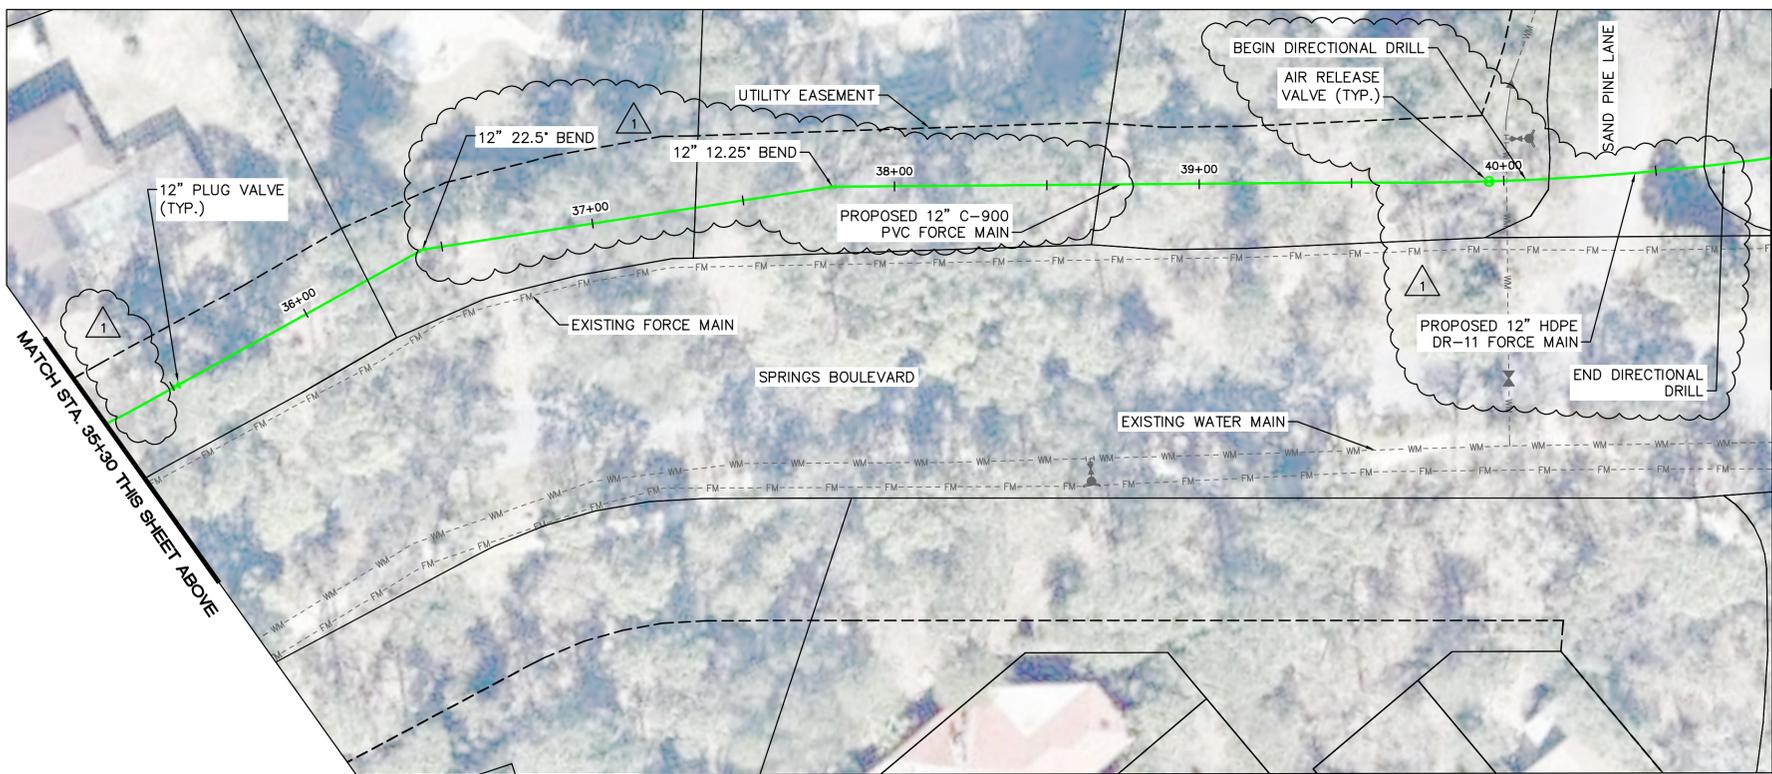

MATCH STA. 35+30 THIS SHEET ABOVE

MATCH STA. 40+80 SHEET 7

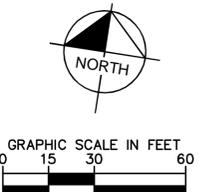

- LEGEND**
- WM --- EXISTING WATER MAIN
 - FM --- EXISTING FORCE MAIN
 - SS --- EXISTING SANITARY SEWER
 - UE --- UTILITY EASEMENT
 - FM --- PROPOSED FORCE MAIN
 - ⊕ AIR RELEASE VALVE
 - ⊕ PLUG VALVE

Always call 811 two full business days before you dig to have underground utilities located and marked.

Sunshine811.com

1	ADDENDUM 1	11/18/16	RL
No.	REVISIONS	DATE	BY

Kimley»Horn

© 2016 KIMLEY-HORN AND ASSOCIATES, INC.

3660 MAGUIRE BOULEVARD, SUITE 200, ORLANDO, FL 32803
 PHONE: 407-898-1511
 WWW.KIMLEY-HORN.COM CA 00000696

KHA PROJECT	149685007
DATE	11/7/16
SCALE	AS SHOWN
DESIGNED BY	SNR
DRAWN BY	JIH
CHECKED BY	NEQ


SPRINGS BLVD FORCE MAIN

LICENSED PROFESSIONAL	STEPHEN N. ROMANO, P.E.
57579	
DATE:	----


STA 30+30 TO 40+80

SHEET NUMBER	6
--------------	---


This document, together with the concepts and designs presented herein, is intended only for the specific purpose and client for which it was prepared. Reuse of any information contained herein, in whole or in part, without the written authorization and approval of Kimley-Horn and Associates, Inc. shall be without liability to Kimley-Horn and Associates, Inc.

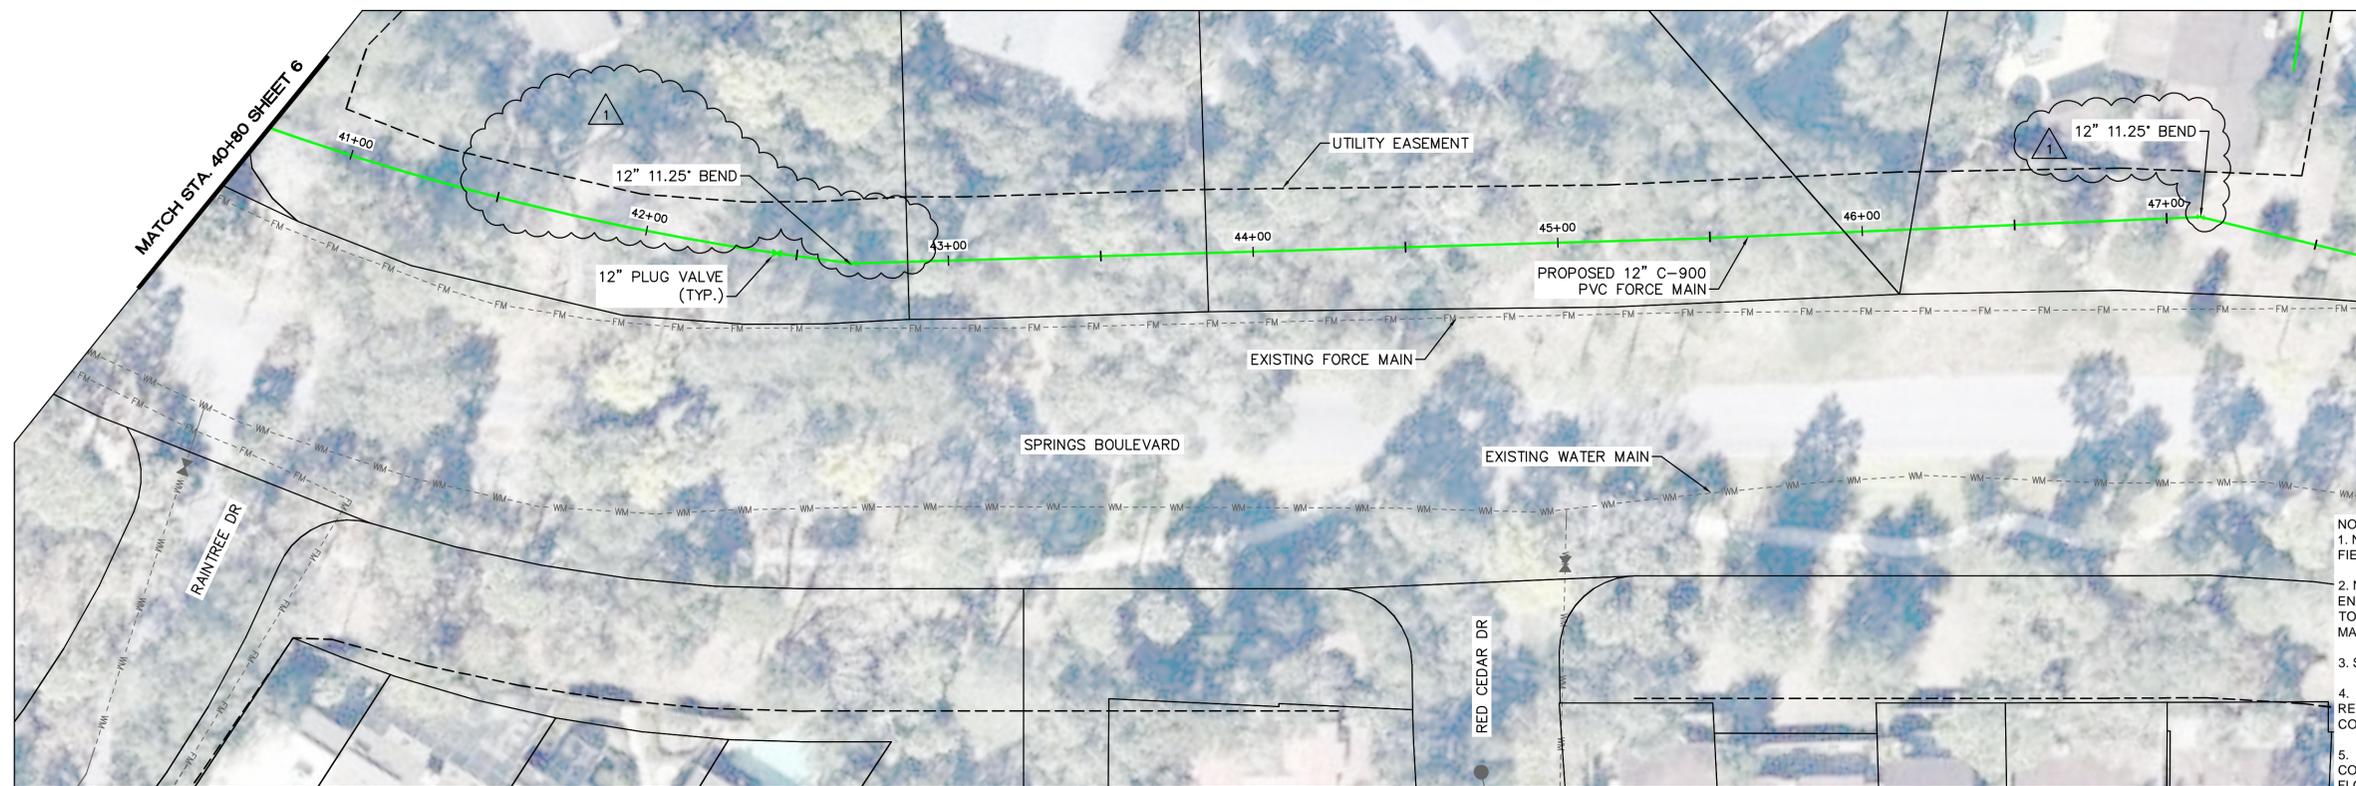


MATCH STA. 47+70 THIS SHEET BELOW

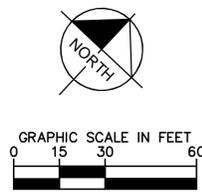

- NOTE:
1. NO NEW SURVEY WAS OBTAIN FOR THIS PROJECT. CONTRACTOR MUST FIELD VERIFY LOCATIONS OF EXISTING UTILITIES
 2. NO TREES SHALL BE REMOVED UNLESS SPECIFICALLY ALLOWED BY THE ENGINEER AND COUNTY R.O.W. PERMIT. ALIGNMENT MAY BE ADJUSTED TO PROTECT EXIST. TREES. NO ADDITIONAL COMPENSATION WILL BE MADE FOR THERE ADJUSTMENTS.
 3. SIDEWALK MAY BE REMOVED AND REPLACED AS NECESSARY.
 4. ALL PROPERTY OWNERS WHOSE DRIVEWAYS REQUIRED REPLACEMENT WILL BE INDIVIDUALLY CONTACTED PRIOR TO CONSTRUCTION.
 5. CONSTRUCTION ACTIVITIES WITHIN 2 MILES OF A SCHOOL WILL BE COORDINATED WITH THE SCHOOL TO ENSURE THE SAFE CONTINUOUS FLOW OF PROPER PEDESTRIAN TRAFFIC FOR SCHOOL CHILDREN.
 6. ALL UTILITIES WILL BE PHYSICALLY VERIFIED PRIOR TO CONSTRUCTION.

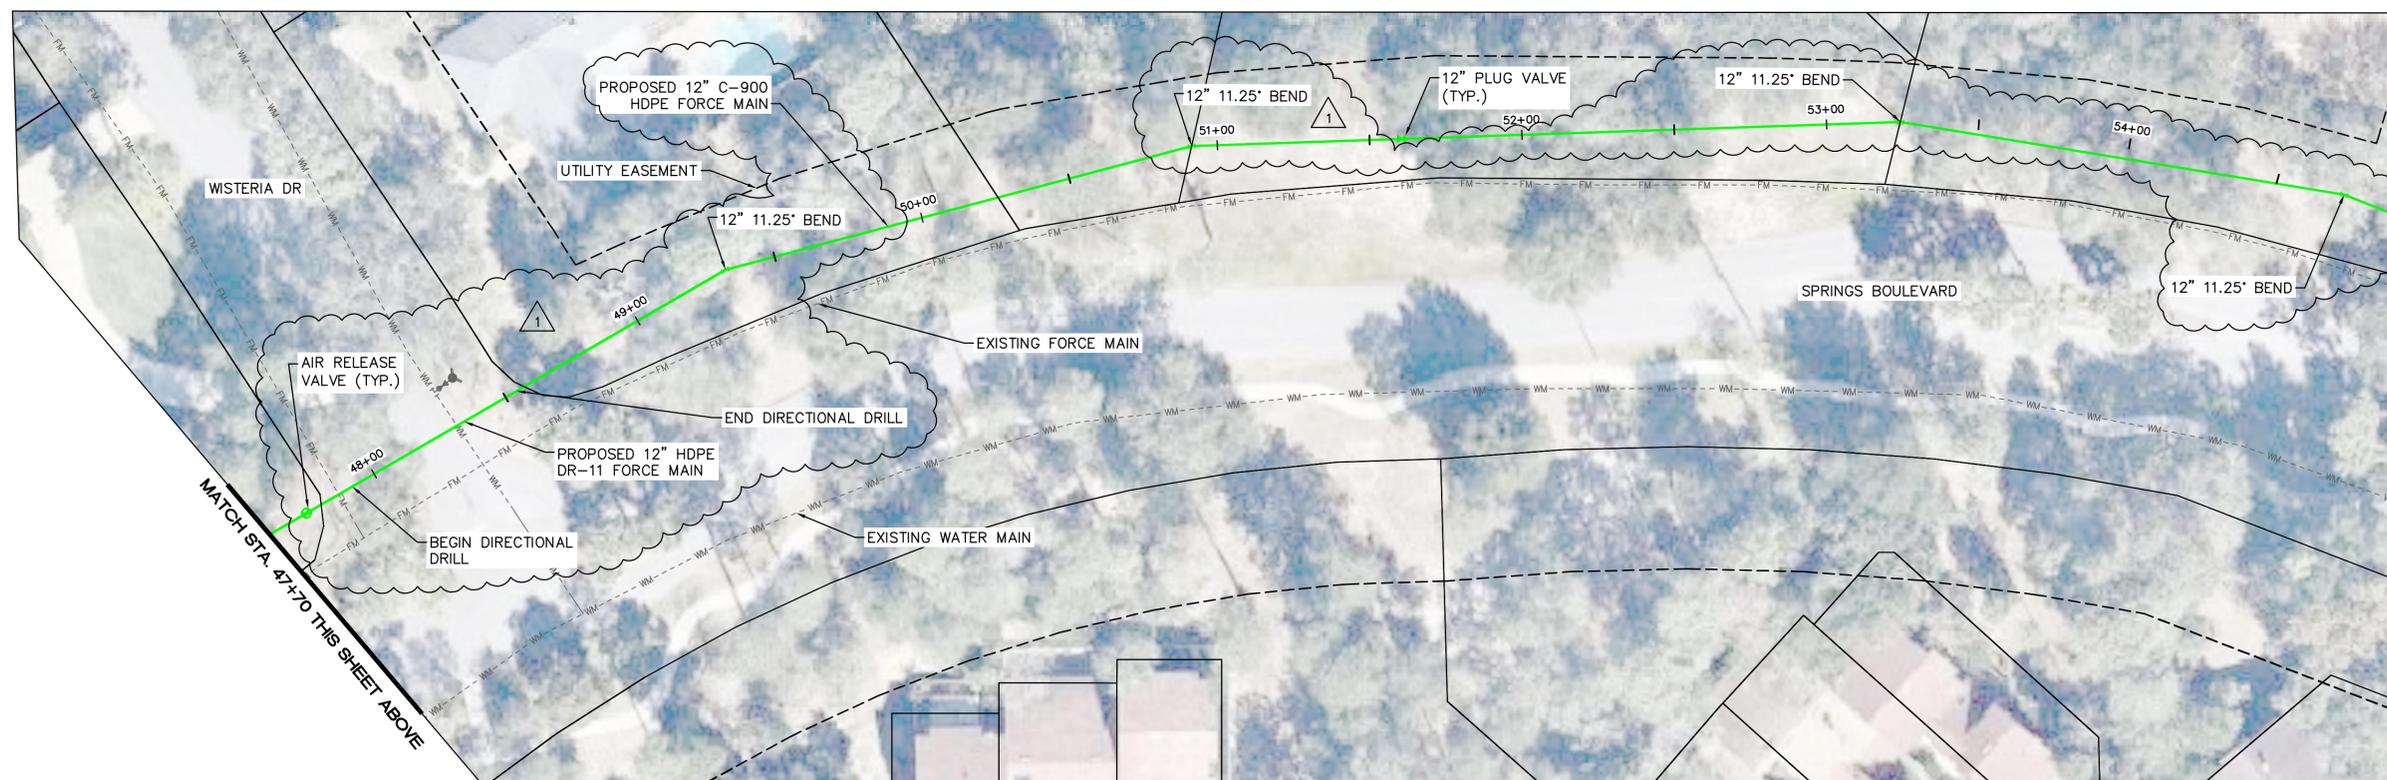

MATCH STA. 54+75 SHEET 8

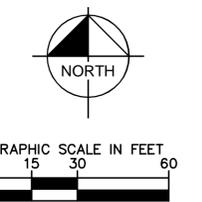

- LEGEND**
- WM --- EXISTING WATER MAIN
 - FM --- EXISTING FORCE MAIN
 - SS --- EXISTING SANITARY SEWER
 - UE --- UTILITY EASEMENT
 - FM --- PROPOSED FORCE MAIN
 - ⊕ AIR RELEASE VALVE
 - ⊕ PLUG VALVE

Always call 811 two full business days before you dig to have underground utilities located and marked.

1	ADDENDUM 1	11/18/16	RL
No.	REVISIONS	DATE	BY

Kimley»Horn

© 2016 KIMLEY-HORN AND ASSOCIATES, INC.
 3660 MAGUIRE BOULEVARD, SUITE 200, ORLANDO, FL 32803
 PHONE: 407-898-1511
 WWW.KIMLEY-HORN.COM CA 00000696

KHA PROJECT
149685007
 DATE
11/7/16
 SCALE AS SHOWN
 DESIGNED BY SNR
 DRAWN BY JIH
 CHECKED BY NEQ

SPRINGS BLVD FORCE MAIN



LICENSED PROFESSIONAL
 STEPHEN N. ROMANO, P.E.
 57579
 DATE: _____

STA 40+80 TO 54+75

SHEET NUMBER
7

This document, together with the concepts and designs presented herein, is intended only for the specific purpose and client for which it was prepared. Review of any improper reference on this document without written authorization and adaptation by Kimley-Horn and Associates, Inc. shall be without liability to Kimley-Horn and Associates, Inc.



MATCH STA. 54+75 SHEET 7

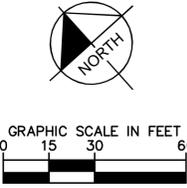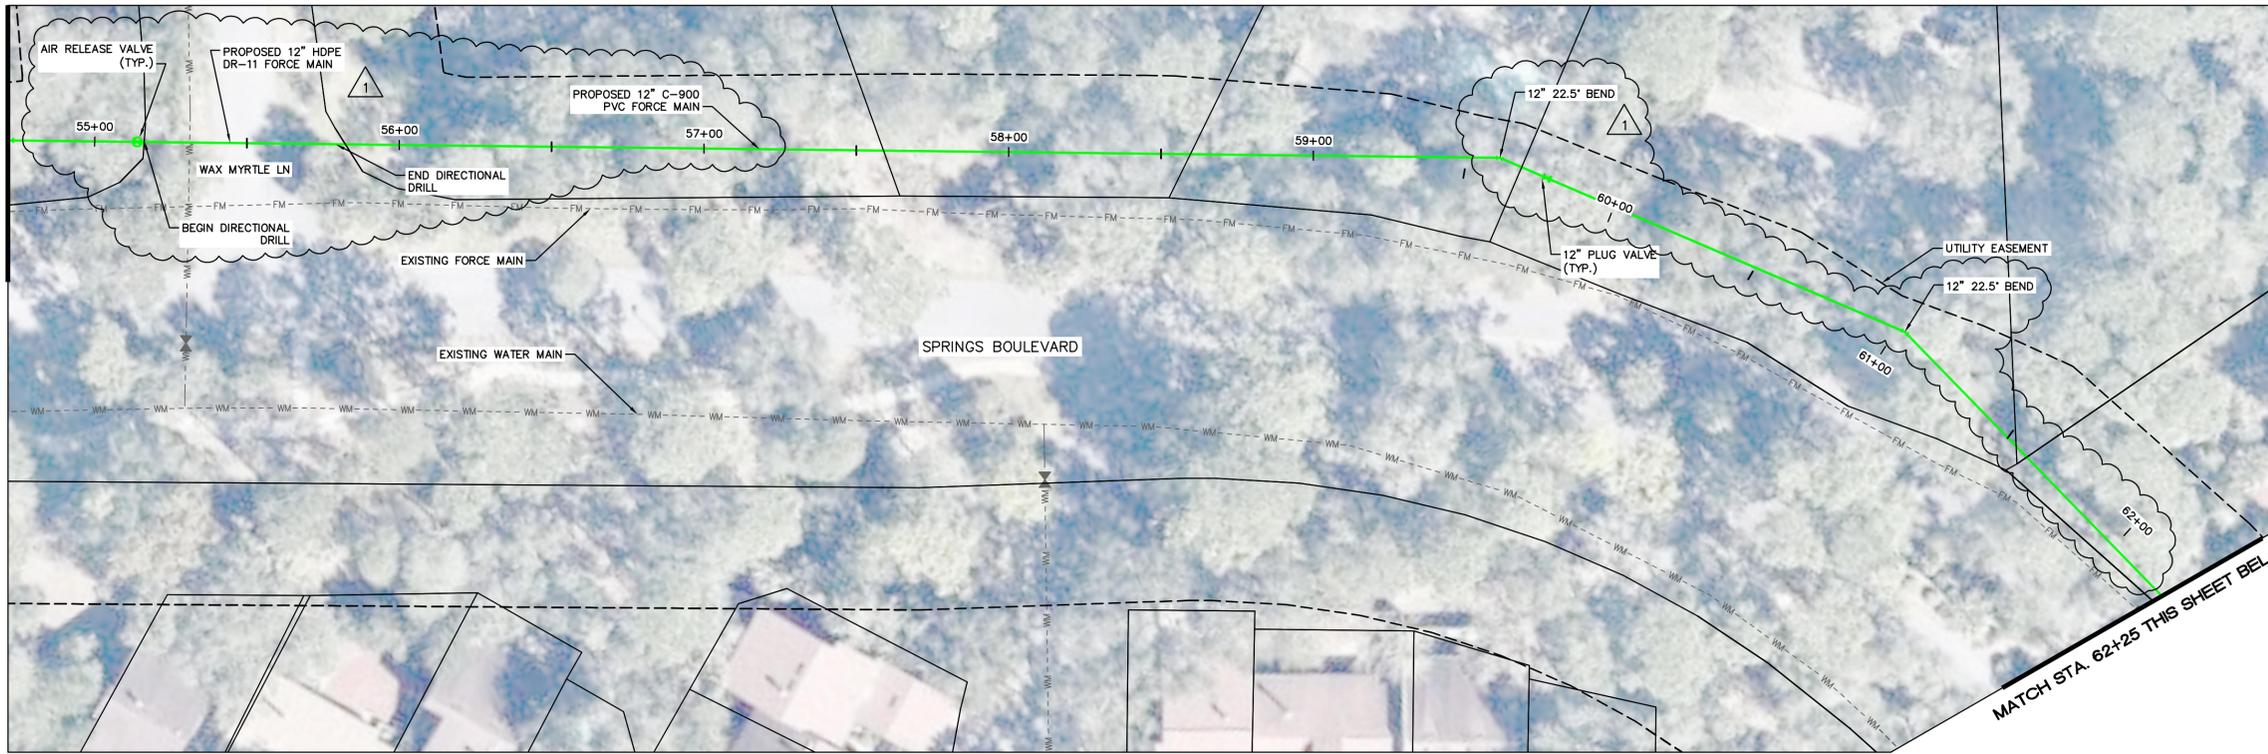

- NOTE:
1. NO NEW SURVEY WAS OBTAIN FOR THIS PROJECT. CONTRACTOR MUST FIELD VERIFY LOCATIONS OF EXISTING UTILITIES
 2. NO TREES SHALL BE REMOVED UNLESS SPECIFICALLY ALLOWED BY THE ENGINEER AND COUNTY R.O.W. PERMIT. ALIGNMENT MAY BE ADJUSTED TO PROTECT EXIST. TREES. NO ADDITIONAL COMPENSATION WILL BE MADE FOR THERE ADJUSTMENTS.
 3. SIDEWALK MAY BE REMOVED AND REPLACED AS NECESSARY.
 4. ALL PROPERTY OWNERS WHOSE DRIVEWAYS REQUIRED REPLACEMENT WILL BE INDIVIDUALLY CONTACTED PRIOR TO CONSTRUCTION.
 5. CONSTRUCTION ACTIVITIES WITHIN 2 MILES OF A SCHOOL WILL BE COORDINATED WITH THE SCHOOL TO ENSURE THE SAFE CONTINUOUS FLOW OF PROPER PEDESTRIAN TRAFFIC FOR SCHOOL CHILDREN.
 6. ALL UTILITIES WILL BE PHYSICALLY VERIFIED PRIOR TO CONSTRUCTION.

MATCH STA. 62+25 THIS SHEET BELOW

MATCH STA. 62+25 THIS SHEET ABOVE

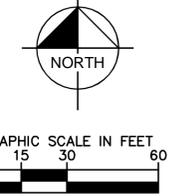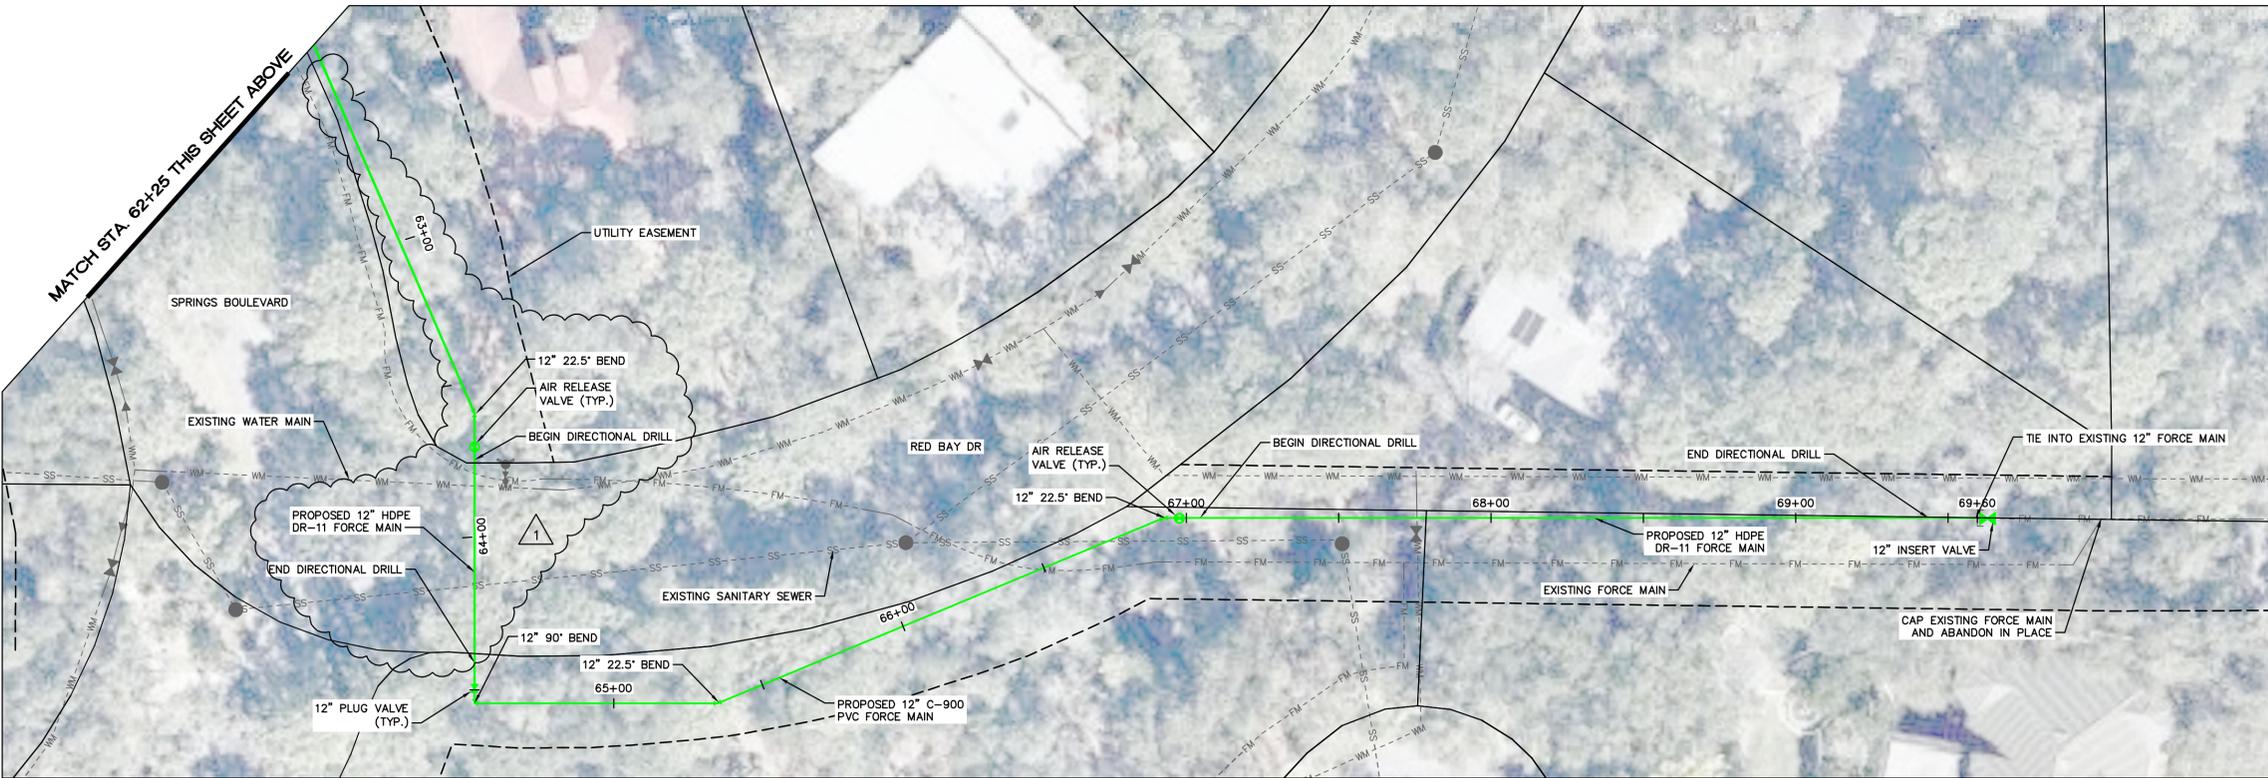

- LEGEND**
- WM --- EXISTING WATER MAIN
 - FM --- EXISTING FORCE MAIN
 - SS --- EXISTING SANITARY SEWER
 - UE --- UTILITY EASEMENT
 - FM --- PROPOSED FORCE MAIN
 - AIR RELEASE VALVE
 - PLUG VALVE

Always call 811 two full business days before you dig to have underground utilities located and marked.

Sunshine811.com

No.	REVISIONS	DATE	BY
1	ADDENDUM 1	11/18/16	RLL

Kimley»Horn

© 2016 KIMLEY-HORN AND ASSOCIATES, INC.

3660 MAGUIRE BOULEVARD, SUITE 200, ORLANDO, FL 32803
 PHONE: 407-898-1511
 WWW.KIMLEY-HORN.COM CA 0000696

KHA PROJECT
149685007

DATE
11/7/16

SCALE AS SHOWN

DESIGNED BY SNR

DRAWN BY JIH

CHECKED BY NEQ

SPRINGS BLVD FORCE MAIN

LICENSED PROFESSIONAL

STEPHEN N. ROMANO, P.E.

57579



DATE: _____

STA 54+75 TO 69+60



SHEET NUMBER

8

This document, together with the concepts and designs presented herein, is intended only for the specific purpose and client for which it was prepared. Reuse of any information or reliance on this document without written authorization and adaptation by Kimley-Horn and Associates, Inc. shall be without liability to Kimley-Horn and Associates, Inc.

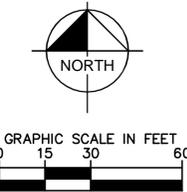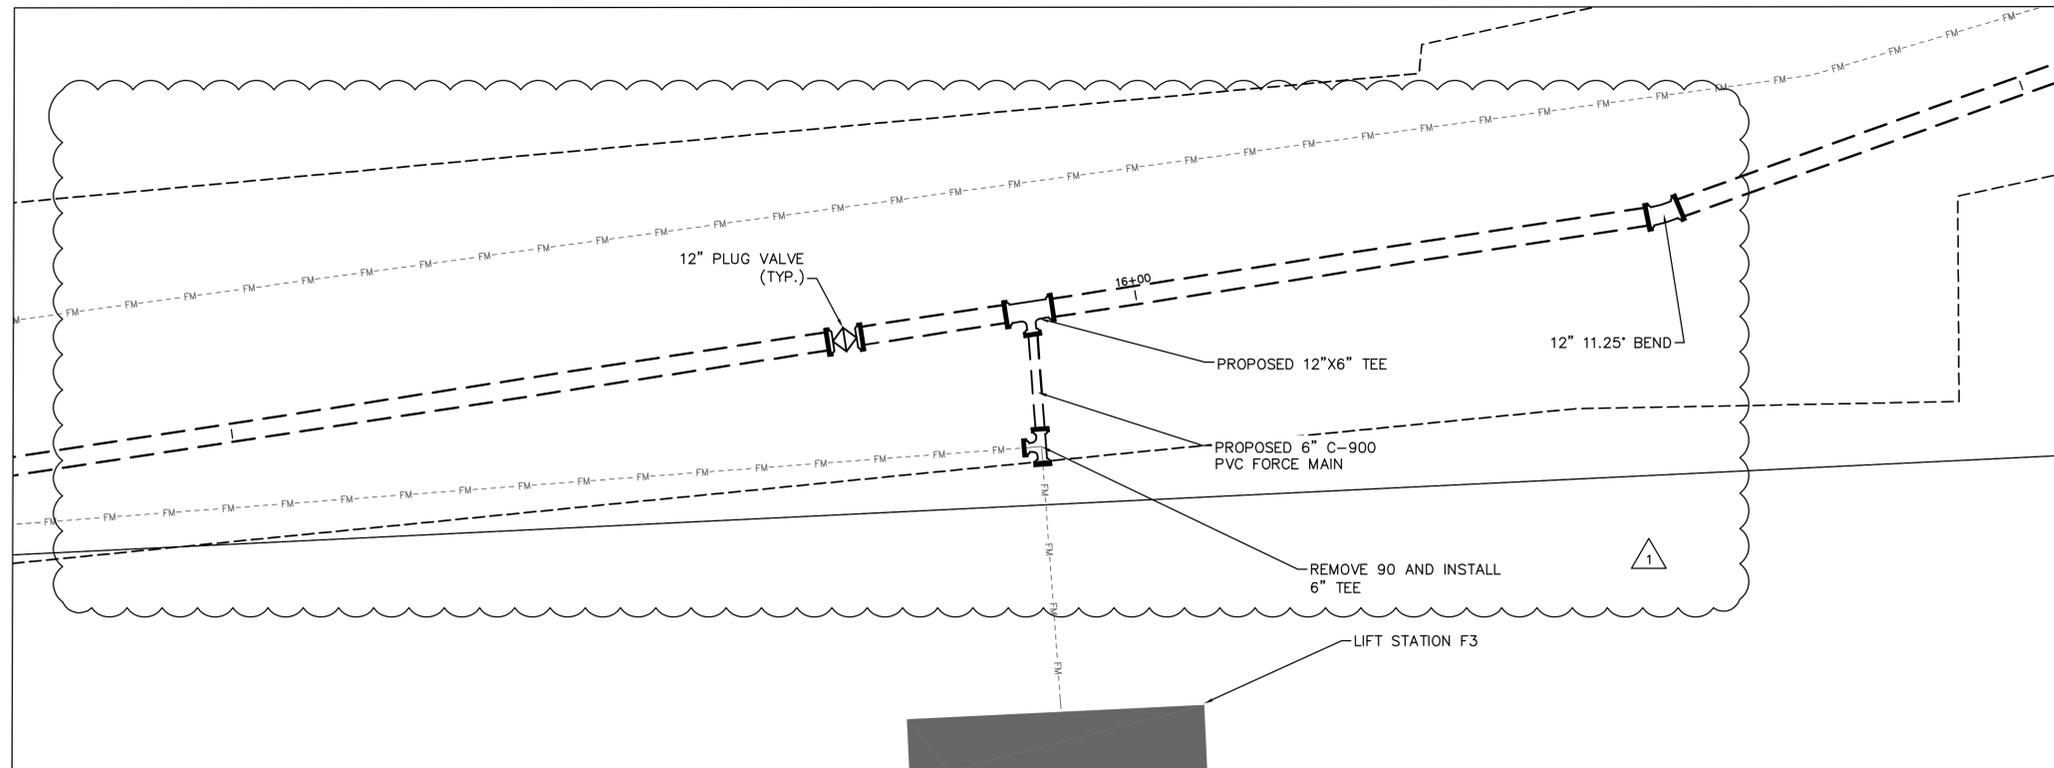

- NOTE:
1. NO NEW SURVEY WAS OBTAIN FOR THIS PROJECT. CONTRACTOR MUST FIELD VERIFY LOCATIONS OF EXISTING UTILITIES
 2. NO TREES SHALL BE REMOVED UNLESS SPECIFICALLY ALLOWED BY THE ENGINEER AND COUNTY R.O.W. PERMIT. ALIGNMENT MAY BE ADJUSTED TO PROTECT EXIST. TREES. NO ADDITIONAL COMPENSATION WILL BE MADE FOR THERE ADJUSTMENTS.
 3. SIDEWALK MAY BE REMOVED AND REPLACED AS NECESSARY.
 4. ALL PROPERTY OWNERS WHOSE DRIVEWAYS REQUIRED REPLACEMENT WILL BE INDIVIDUALLY CONTACTED PRIOR TO CONSTRUCTION.
 5. CONSTRUCTION ACTIVITIES WITHIN 2 MILES OF A SCHOOL WILL BE COORDINATED WITH THE SCHOOL TO ENSURE THE SAFE CONTINUOUS FLOW OF PROPER PEDESTRIAN TRAFFIC FOR SCHOOL CHILDREN.
 6. ALL UTILITIES WILL BE PHYSICALLY VERIFIED PRIOR TO CONSTRUCTION.

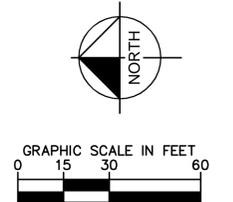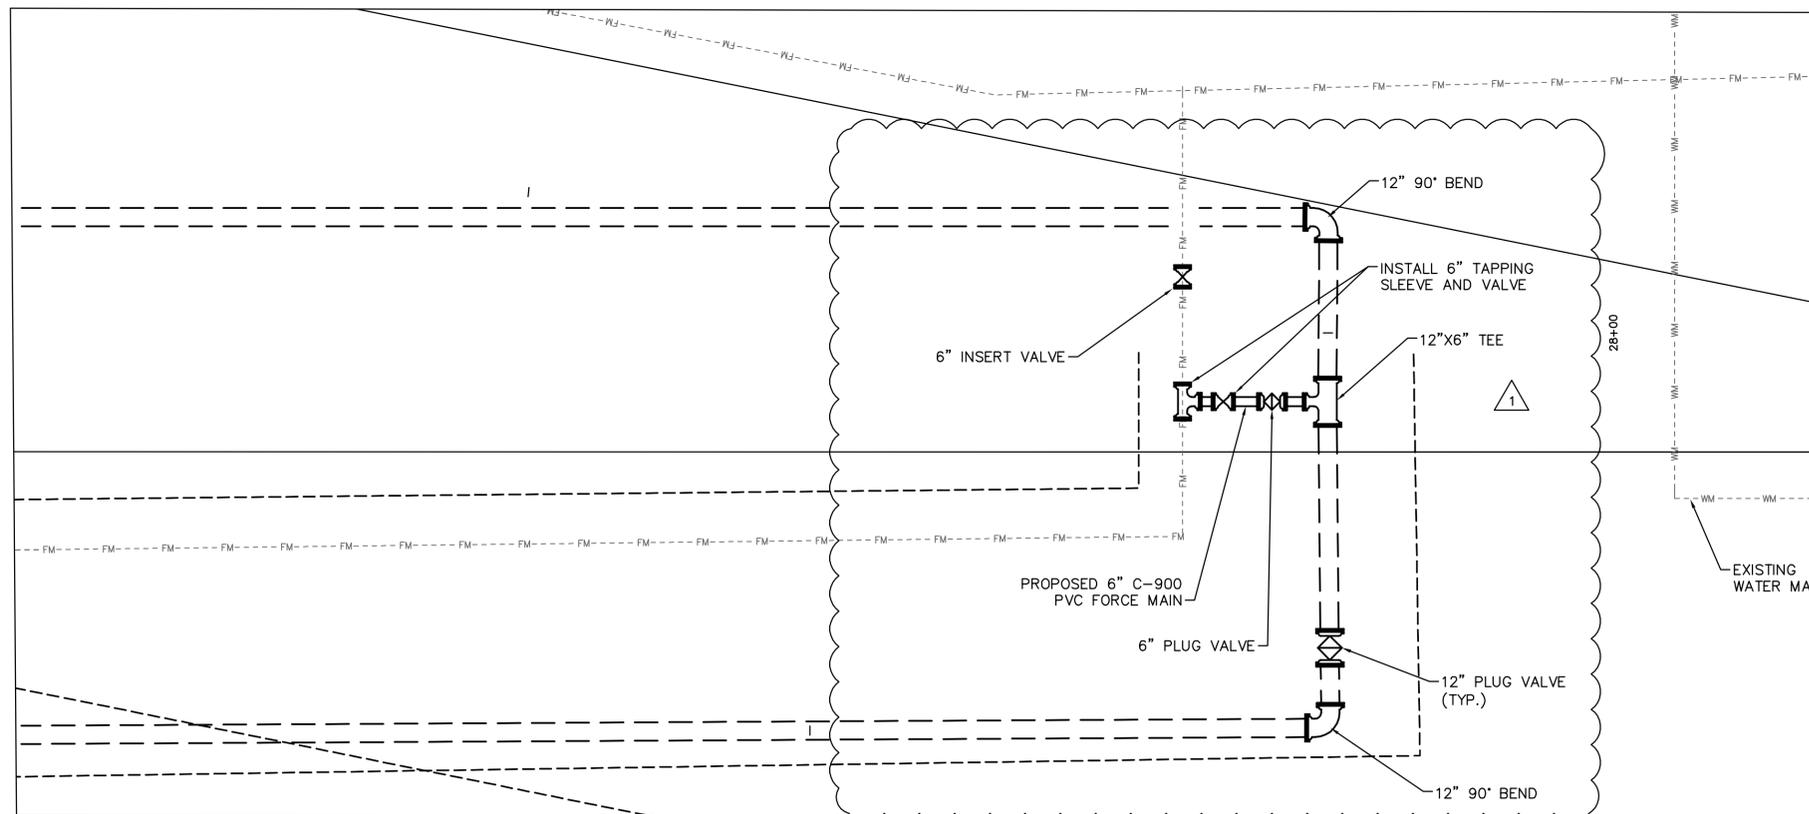

- LEGEND**
- EXISTING WATER MAIN
 - FM- EXISTING FORCE MAIN
 - EXISTING SANITARY SEWER
 - - - UTILITY EASEMENT
 - PROPOSED FORCE MAIN
 - ⊗ AIR RELEASE VALVE
 - ⊕ PLUG VALVE

Always call 811 two full business days before you dig to have underground utilities located and marked.

1	ADDENDUM 1	11/18/16	RLL
No.	REVISIONS	DATE	BY

Kimley»Horn

© 2016 KIMLEY-HORN AND ASSOCIATES, INC.

3660 MAGUIRE BOULEVARD, SUITE 200, ORLANDO, FL 32803
 PHONE: 407-898-1511
 WWW.KIMLEY-HORN.COM CA 0000696

KHA PROJECT	149685007
DATE	11/7/16
SCALE	AS SHOWN
DESIGNED BY	SNR
DRAWN BY	JIH
CHECKED BY	NEQ

SPRINGS BLVD FORCE MAIN

LICENSED PROFESSIONAL

STEPHEN N. ROMANO, P.E.

57579


DATE: _____

**LIFT STATION F3 DETAIL/
SPRINGS BLVD CONNECTION DETAIL**

SHEET NUMBER


9

This document, together with the concepts and designs presented herein, is intended only for the specific purpose and client for which it was prepared. Reuse of any information contained herein, or an instrument of service, is intended only for the specific purpose and client for which it was prepared. Reuse of any information contained herein, or an instrument of service, is intended only for the specific purpose and client for which it was prepared. Reuse of any information contained herein, or an instrument of service, is intended only for the specific purpose and client for which it was prepared.

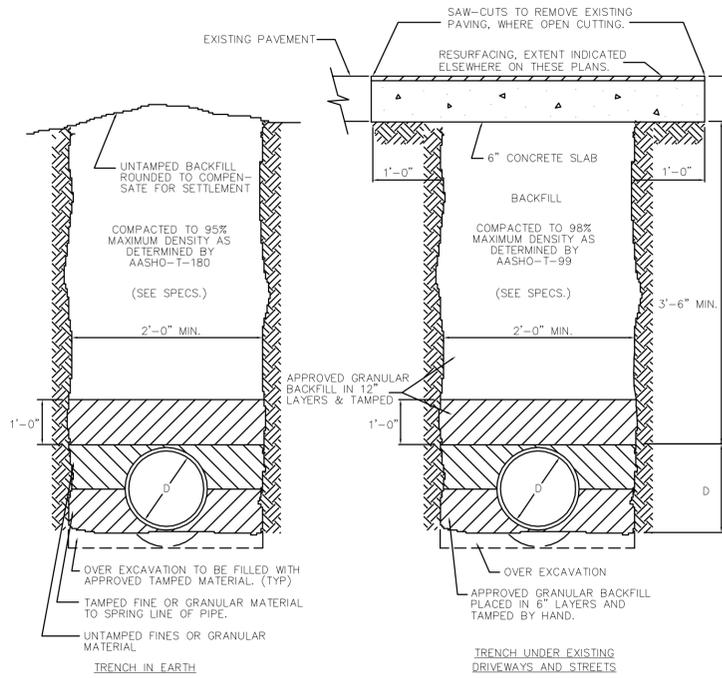

- NOTE**
- TRENCHES SHALL BE AS NARROW AS POSSIBLE TO ALLOW FOR SAFE AND PROPER PIPE INSTALLATION. TRENCH SIDES SHALL BE VERTICAL TO A POINT 1'-0" ABOVE THE TOP OF THE PIPE. ABOVE THIS POINT SLOPED SIDES MAY BE USED IF CONDITIONS PERMIT, BUT SHOULD BE KEPT AS NEARLY VERTICAL AS POSSIBLE.
 - FOR TRENCH IN CINDER FILLS, GARBAGE DUMPS, SALT MARSHES, MUCK SOILS OR PLACES WHERE HARMFUL CORROSIVE CONDITIONS EXIST, PIPE SHALL BE PROTECTED WITH AT LEAST 10" OF SAND OR LIMESTONE SCREENINGS ON ALL SIDES AND TAMPED BY HAND IN 6" LAYERS. SEE SPECIFICATIONS. NO ADDITIONAL COMPENSATION FOR CORROSION PROTECTION OF A PIPE WILL BE ALLOWED.

TRENCH DETAILS

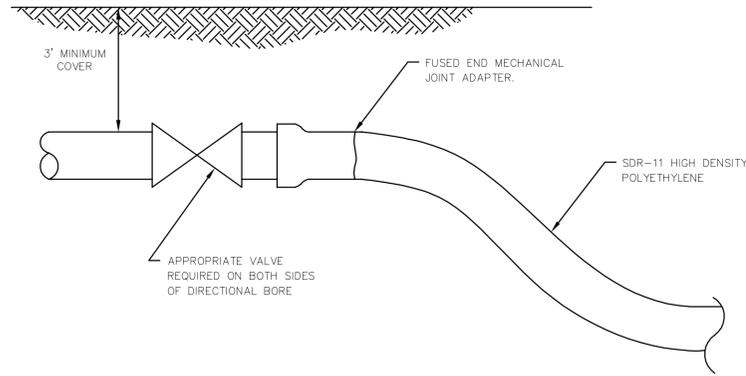

- NOTES:**
- DEPTH OF DIRECTIONAL BORE SHALL BE APPROVED ON A CASE BY CASE BASIS.
 - CONTRACTOR MUST COMPLY WITH ALL APPLICABLE FDOT, FDEP, ACOE, AND WATER MANAGEMENT DISTRICT REQUIREMENTS.

DIRECTIONAL BORE DETAILS

PROPOSED UTILITY	MINIMUM HORIZONTAL AND VERTICAL SEPARATION REQUIREMENTS									
	POTABLE WATER		RECLAIMED WATER*		SANITARY SEWER FORCE MAIN		SANITARY SEWER GRAVITY MAIN		STORM SEWER OR VACUUM TYPE SANITARY SEWER	
	HORIZONTAL	VERTICAL	HORIZONTAL	VERTICAL	HORIZONTAL	VERTICAL	HORIZONTAL	VERTICAL	HORIZONTAL	VERTICAL
POTABLE WATER	---	---	3'	12"	6'	12"	6' **	6" ABOVE 12" BELOW	3'	6" ABOVE 12" BELOW
RECLAIMED WATER	3'	12"	---	---	3'	12"	3'	12"	---	---
SANITARY SEWER FORCE MAIN	6'	12"	3'	12"	---	---	---	---	---	---
SANITARY SEWER GRAVITY MAIN	6' **	6" ABOVE 12" BELOW	3'	12"	---	---	---	---	---	---
FIRE HYDRANTS W/ UNDERGROUND DRAINS	---	---	3'	---	6'	---	6'	---	3'	---


- THE TABLE REPRESENTS THE MINIMUM SEPARATION REQUIREMENTS AS DESCRIBED IN F.D.E.P. RULES PER THE FLORIDA ADMINISTRATION CODE (F.A.C.). THESE SEPARATION REQUIREMENTS SHALL APPLY BETWEEN NEWLY PROPOSED UTILITY LINES AND EXISTING OR PROPOSED UTILITY LINES.
- FOR THE PURPOSE OF THIS TABLE RECLAIMED WATER SHALL MEAN UNRESTRICTED PUBLIC ACCESS REUSE WATER AS DEFINED BY F.A.C. 62-610. OTHER TYPES OF RECLAIMED WATER ARE CONSIDERED RAW SEWAGE AND SEPARATION DISTANCES LISTED FOR SANITARY SEWER SHALL APPLY.
- ALL SEPARATION DISTANCES ARE FROM OUTSIDE OF PIPE TO OUTSIDE OF PIPE.
- THE MINIMUM HORIZONTAL SEPARATION BETWEEN POTABLE WATER AND GRAVITY SANITARY SEWER MAY BE REDUCED TO 3 FEET IF THE BOTTOM OF THE WATER MAIN IS LOCATED AT LEAST 6 INCHES ABOVE THE TOP OF THE GRAVITY SEWER.
 - AT LEAST 3' FROM ALL JOINTS IN VACUUM TYPE SANITARY SEWERS, STORM SEWERS, STORMWATER FORCE MAINS, OR UNRESTRICTED PUBLIC ACCESS RECLAIMED WATER.
 - AT LEAST 6' FROM ALL JOINTS IN GRAVITY OR PRESSURE SANITARY SEWERS, WASTEWATER FORCE MAINS, AND ALL OTHER TYPES OF RECLAIMED WATER.
- NO WATER PIPE SHALL PASS THROUGH OR BE CONSTRUCTED TOUCHING ANY PART OF A SANITARY MANHOLE OR STORM SEWER MANHOLE OR INLET STRUCTURE.
- NEW OR RELOCATED FIRE HYDRANTS WITH UNDERGROUND DRAINS MUST BE AT LEAST 10 FEET FROM ANY EXISTING OR PROPOSED "ON-SITE SEWAGE TREATMENT AND DISPOSAL SYSTEM" AS DEFINED IN SECTION 391.0065 (2), F.S., AND RULE 64E-6.002, F.A.C. (E.G. SEPTIC TANKS, DRAIN FIELDS, AND GREASE TRAPS).
- THE FOLLOWING ARE ACCEPTABLE ALTERNATIVE CONSTRUCTION VARIANCES WHERE IT IS NOT POSSIBLE TO MEET THE SEPARATION REQUIREMENTS, AND ARE ONLY TO BE IMPLEMENTED UPON RECEIPT OF EXPRESSED WRITTEN CONSENT FROM THE ENGINEER.
 - WHERE A WATER MAIN IS BEING LAID LESS THAN THE REQUIRED MINIMUM HORIZONTAL DISTANCE AND/OR WHERE A WATER MAIN CROSSING HAS LESS THAN THE MINIMUM REQUIRED DISTANCE BETWEEN JOINTS:
 - USE OF PRESSURE RATED PIPE CONFORMING TO AWWA STANDARDS, FOR A GRAVITY OR VACUUM TYPE PIE LINE.
 - USE OF WELDED, FUSED OR OTHERWISE RESTRAINED JOINTS FOR EITHER PIPE.
 - USE OF WATERTIGHT CASING PIPE OR CONCRETE ENCASEMENT AT LEAST 4" THICK FOR EITHER PIPE.
 - WHERE A WATER MAIN IS BEING LAID LESS THAN 3 FEET HORIZONTALLY FROM ANOTHER PIPE LINE AND/OR WHERE A WATER MAIN IS BEING LAID WITH LESS THAN THE REQUIRED MINIMUM VERTICAL SEPARATION:
 - USE OF PIPE OR CASING PIPE, HAVING HIGH IMPACT STRENGTH (AT LEAST EQUAL TO 0.25" THICK D.I.P.), OR CONCRETE ENCASEMENT AT LEAST 4" THICK FOR THE WATER MAIN AND THE OTHER PIPE LINE IF THE OTHER PIPE LINE CONVEYS WASTEWATER OR RECLAIMED WATER.

MINIMUM HORIZONTAL AND VERTICAL SEPARATION REQUIREMENTS


PIPE RESTRAINT FOR PVC PIPE (C-900/C-905 DR 18)												
MINIMUM RESTRAINED LENGTH (FT) - EACH SIDE OF FITTING												
FITTING TYPE	PIPE SIZE - INCHES											
	4	6	8	10	12	14	16	18	20	24	30	36
VERTICAL UP OR HORIZONTAL												
11-1/4 BEND	2	3	4	5	6	6	7	8	9	10		
22-1/2 BEND	5	6	8	10	12	13	15	16	17	20		
45 BEND	10	13	17	21	24	27	30	33	36	41		
90 BEND	23	32	42	50	58	66	73	80	87	100		
VERTICAL DOWN												
11-1/4 BEND	6	8	10	12	14	16	18	20	22	25		
22-1/2 BEND	11	16	20	24	28	32	36	40	43	50		
45 BEND	23	33	42	51	59	67	75	83	91	105		
90 BEND	56	79	102	122	143	163	182	201	219	253		
BRANCH OF TEE	20	41	63	83	103	129	141	159	177	210		
DEAD END	56	79	102	122	143	163	182	201	219	253		
REDUCERS												
SIZE	6X4	8X4	8X6	10X6	10X8	12X6	12X8	12X10	14X6	14X8		
RESTR. LENGTH	41	74	43	76	41	106	77	42	133	108		
SIZE	16X6	16X8	16X12	18X8	18X12	18X16	20X12	20X16	24X12	24X16		
RESTR. LENGTH	159	137	79	163	111	41	141	78	194	142		

- NOTES:**
- SAND-SILT SOIL (COHESIONLESS SOIL WITH 30° INTERNAL FRICTION ANGLE, PIPE FRICTION/SOIL FRICTION RATIO = 0.6, SOIL DENSITY 90 PCF).
 - PIPE LAYING CONDITION 3 (NO SELECT BEDDING OR BACKFILL).
 - 150 PSI DESIGN PRESSURE. FOR 200 PSI DESIGN PRESSURE (FIRE LINES), INCREASE RESTRAINED LENGTH BY 35%.
 - 3 FOOT MINIMUM COVER ON THE PIPE.
 - ALL RESTRAINED JOINT LENGTHS IN FEET.

PIPE JOINT RESTRAINT TABLE

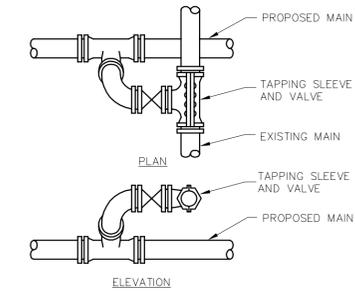

TYPE "B" INTERCONNECTION DETAIL

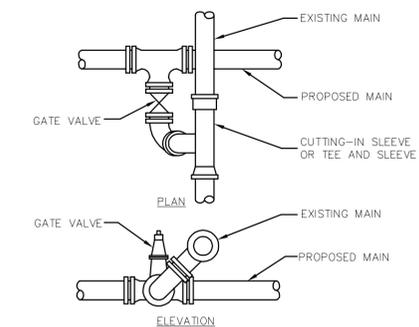


TYPICAL INTERCONNECTION DETAIL

- NOTES:**
- ALTERNATE TYPE PIPE JOINTS WILL BE APPROVED AS INDICATED IN THE SPECIFICATIONS OR GENERAL NOTES.
 - ALL CONCRETE TO HAVE A 28 DAY COMPRESSION STRENGTH OF NOT LESS THAN 2500 PSI.
 - TYPICAL DETAILS AS SHOWN ON THIS SHEET ARE TO ILLUSTRATE THE ENGINEER'S INTENT IN INSTALLING MAINS AND ARE NOT PRESENTED AS A SOLUTION TO ALL CONSTRUCTION PROBLEMS ENCOUNTERED IN THE FIELD. THE CONTRACTOR MAY ALTER THE METHOD OF CONSTRUCTION TO SUIT FIELD CONDITIONS PROVIDING HE SUBMITS PROPOSED ALTERNATE TO THE ENGINEER AND/OR REGULATORY AGENCY FOR APPROVAL AND MATERIAL USE ARE AS DESIGNATED IN THE SPECIFICATIONS.

					KHA PROJECT 149685007 DATE 11/7/16 SCALE AS SHOWN DESIGNED BY SNR DRAWN BY JIH CHECKED BY NEQ		LICENSED PROFESSIONAL STEPHEN N. ROMANO, P.E. 57579 DATE: -----		SHEET NUMBER 10		
			© 2016 KIMLEY-HORN AND ASSOCIATES, INC. 3660 MAGUIRE BOULEVARD, SUITE 200, ORLANDO, FL 32803 PHONE: 407-898-1511 WWW.KIMLEY-HORN.COM CA 00000696		SPRINGS BLVD FORCE MAIN		STANDARD DETAILS				
No.	REVISIONS	DATE	BY								


This document, together with the concepts and designs presented herein, is an instrument of service, is intended only for the specific purpose and client for which it was prepared. Reuse of any information or adaptation by Kimley-Horn and Associates, Inc. shall be without liability to Kimley-Horn and Associates, Inc.

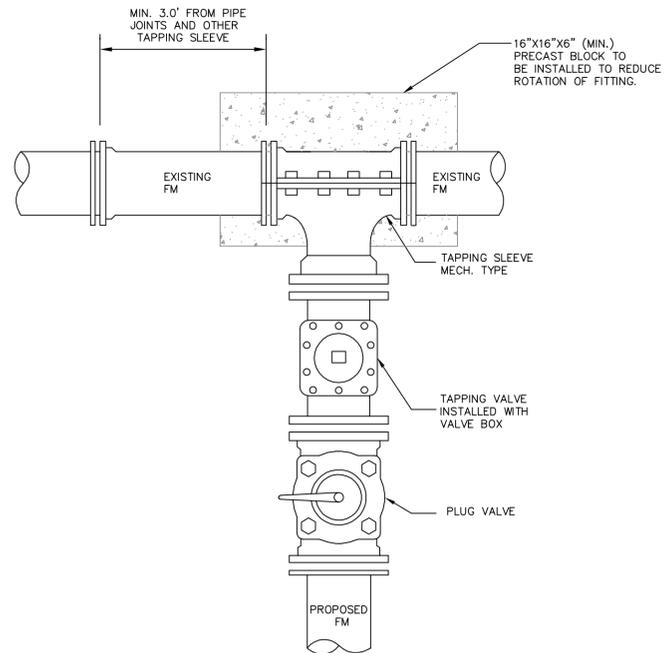

NOTES:


1. EPOXY COATED STEEL, STAINLESS STEEL SLEEVES WITH 316 STAINLESS STEEL BOLTS ARE PERMITTED FOR ALL TYPES OF PIPE MATERIALS.
2. INSTALL REQUIRED RESTRAINED JOINTS. IN NO INSTANCE SHALL THRUST BLOCK BE PERMITTED.

PLAN

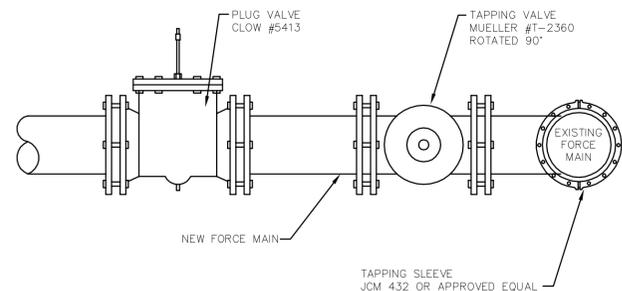

ELEVATION

NEW FORCE MAIN TO EXISTING CONNECTION DETAIL

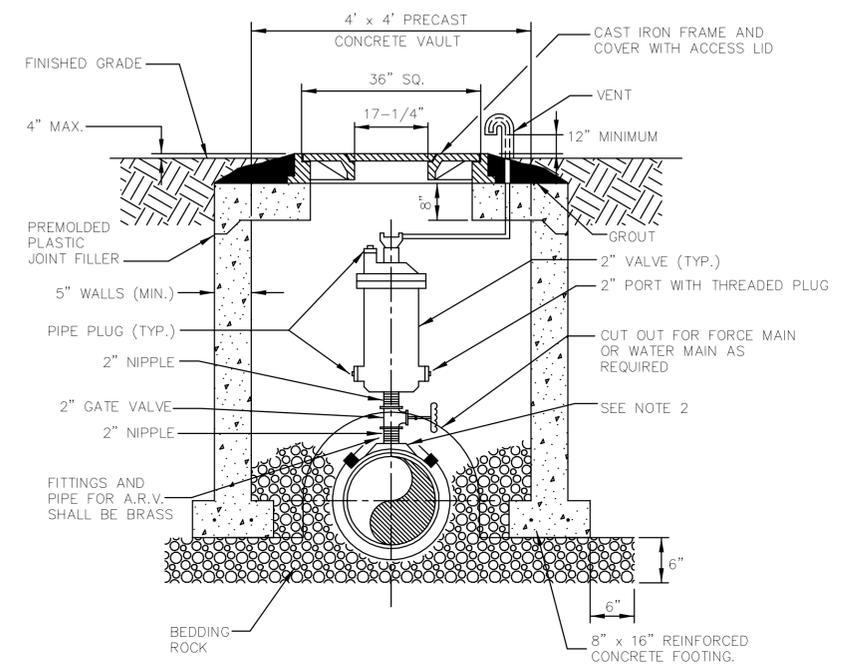

NOTES:

1. ABOVE DETAIL IS BASED ON 2" COMBINATION AIR/VACUUM RELEASE VALVE. CHANGE PIPE AND FITTINGS ACCORDINGLY FOR OTHER VALVE SIZES AND TYPES. VALVE SIZES TO BE DETERMINED BY THE ENGINEER AND APPROVED BY THE UTILITY PRIOR TO INSTALLATION.
2. THE MINIMUM DIMENSION FROM TOP OF PIPE TO FINISHED GRADE SHALL BE 4.0 FEET.
3. IF THE REQUIREMENT FOR AN ABOVE GRADE VENT IS WAIVED BY FDEP, THEN A DOWNTURNED VENT SPOUT MUST BE PLACED INSIDE THE VAULT.

AIR RELIEF VALVE DETAIL

No.	REVISIONS	DATE	BY

Kimley»Horn

© 2016 KIMLEY-HORN AND ASSOCIATES, INC.

3660 MAGUIRE BOULEVARD, SUITE 200, ORLANDO, FL 32803
PHONE: 407-898-1511
WWW.KIMLEY-HORN.COM CA 00000696

KHA PROJECT 149685007
DATE 11/7/16
SCALE AS SHOWN
DESIGNED BY SNR
DRAWN BY JIH
CHECKED BY NEQ

SPRINGS BLVD FORCE MAIN

LICENSED PROFESSIONAL
STEPHEN N. ROMANO, P.E.
57579
DATE: _____

STANDARD DETAILS

SHEET NUMBER
11